


P-48021
C-65735

T.13&14S., R. 31&32E., W.M.

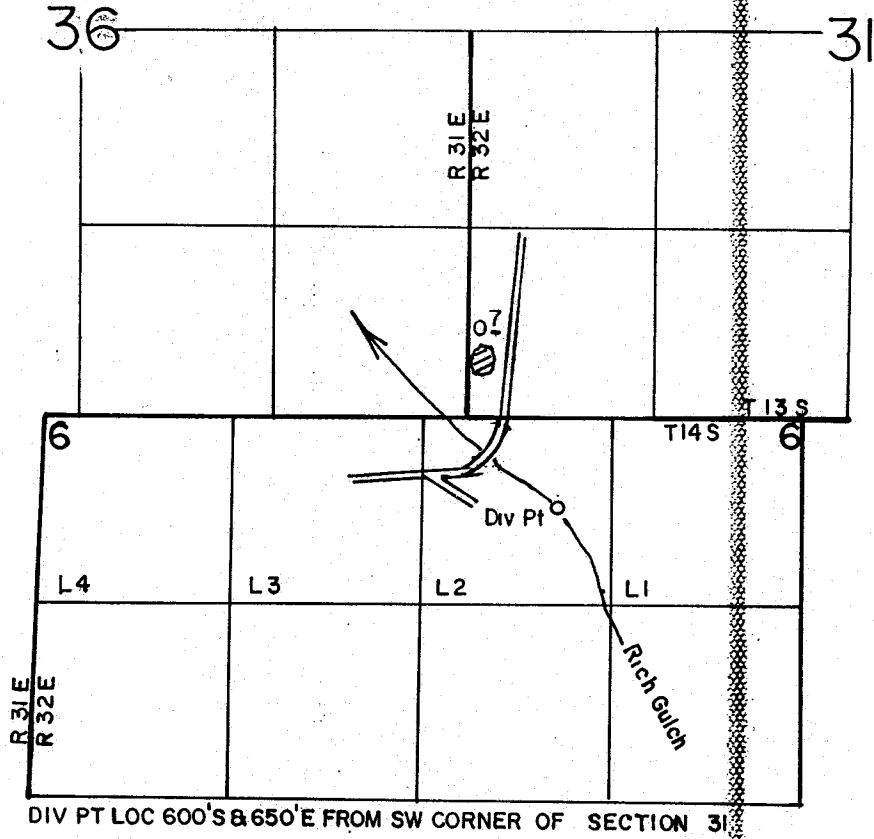

DIV PT LOC 600'S & 650'E FROM SW CORNER OF SECTION 31

SCALE: 1" = 1320'

FINAL PROOF SURVEY
UNDER

Application No. 65817... Permit No. 48021...
IN NAME OF

.....CURTIS.....KOMNING.....

Surveyed JUNE. 22. 1988., by V.L. CHURCH...