


D-48106
C-65734

T. 13S., R. 30E., W.M.

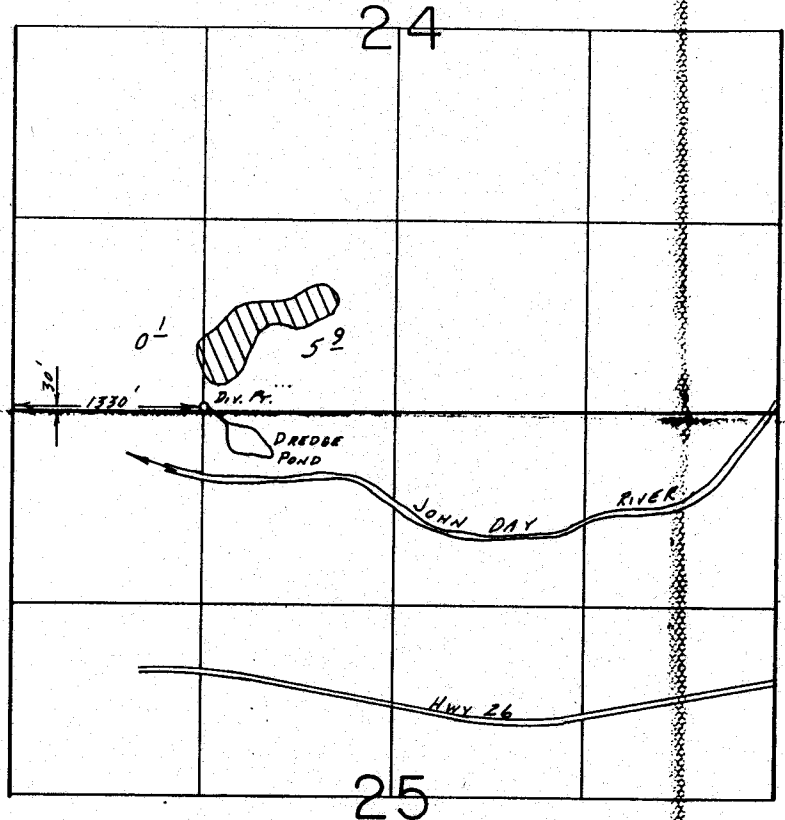

SCALE: 1" = 1320'

FINAL PROOF SURVEY
UNDER

Application No. 66700.. Permit No. 48106
IN NAME OF

MAX MOERY

Surveyed June 20, 1988, by V.L. CHURCH