


T. 27 S., R. 3 W., W. M.

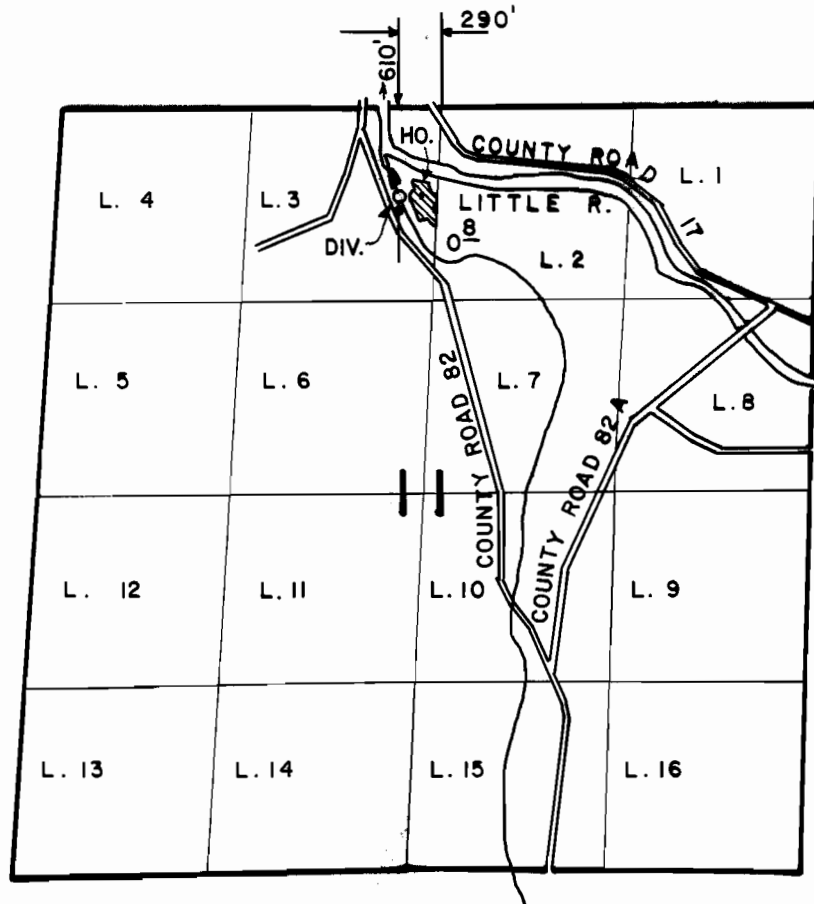

SCALE: 4" = 1 MILE

**FINAL PROOF SURVEY**  
UNDER

Application No. 66724. Permit No. 48122.....  
IN NAME OF

**EDWARD A. YOUNG**

Surveyed JULY 18... 1988., by D.K. CLARK.....