


T. 12 S., R. 9 E., W.M.
SEC. 34
S 1/2 SE 1/4

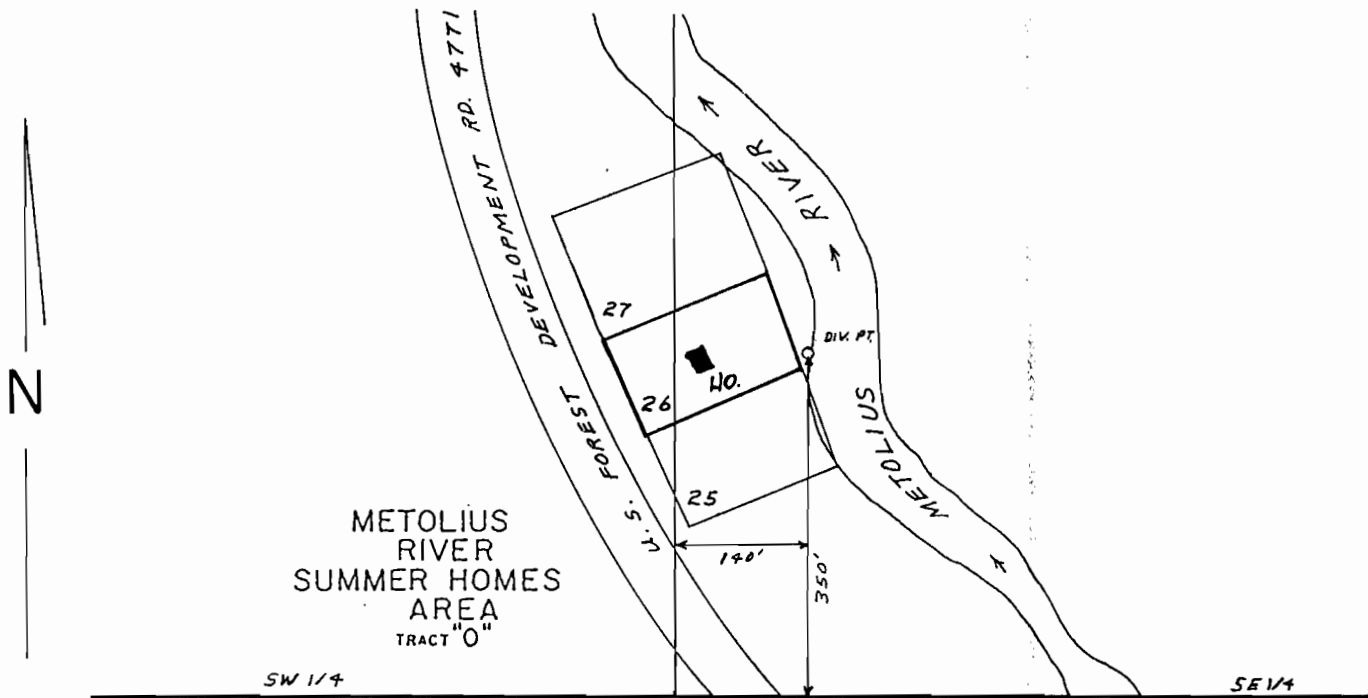

SCALE: 1" = 200'

FINAL PROOF SURVEY
UNDER

Application No. 67511..... Permit No. 48436.....

IN NAME OF

D. S. DENNING JR.

Surveyed MAY 19..... 1988, by B. BISHOP.....