




T. 6 N., R. 35 E., W.M.

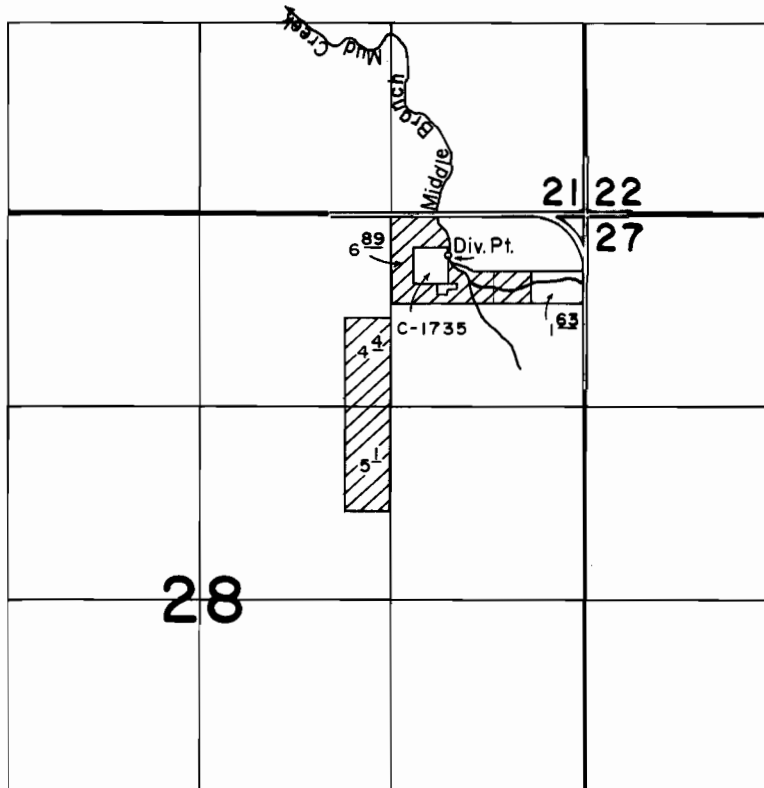

DIV. PT. LOC.: 280' S. & 940' W. FROM N.E. CORNER SECTION 28.

SCALE: 1" = 1320'

**FINAL PROOF SURVEY**  
UNDER

Application No. 68202.. Permit No. 49186.....  
IN NAME OF

.....ERNESTINE ESTOUP.....

Surveyed SEPT. 3. 1989, by J. M. SCHMORDE