


T. 4 S., R. 1 W., W. M.

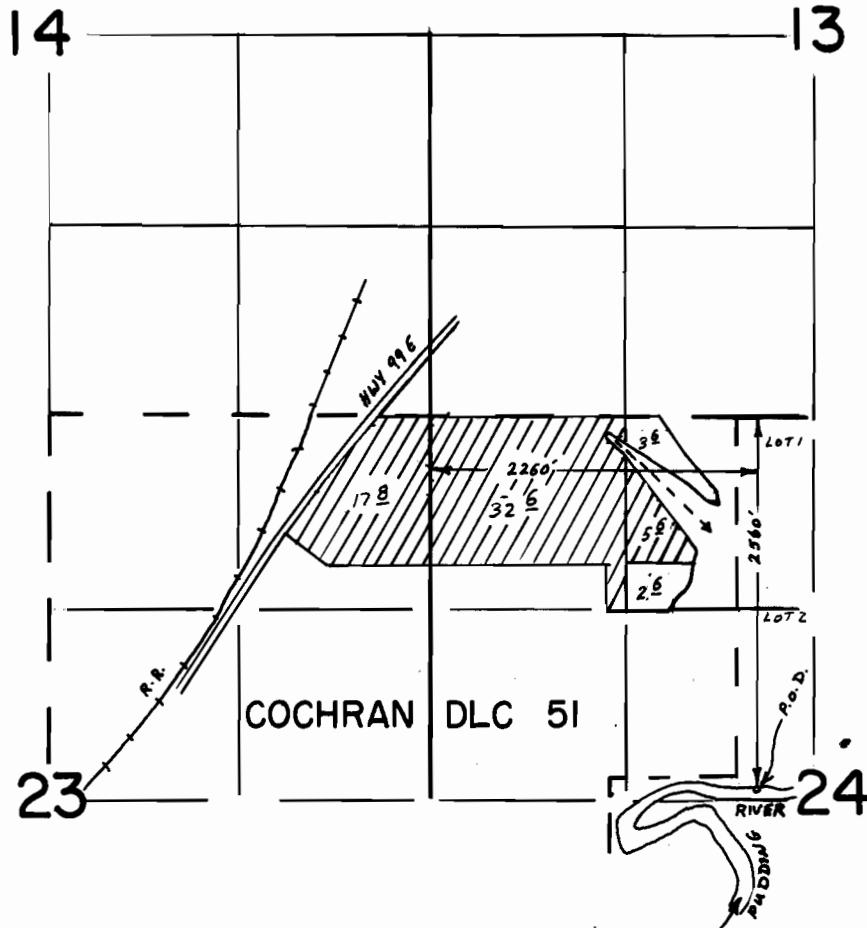

SCALE 1" = 1320'

FINAL PROOF SURVEY UNDER

Application No. **68788** Permit No. **49761**

IN NAME OF

MARTHA BRADTL ELLIOTT

Surveyed **MAY 19 1988**, by **Z. SALEH**