


T26S, R5W, WM

SCALE 1" = 1320'

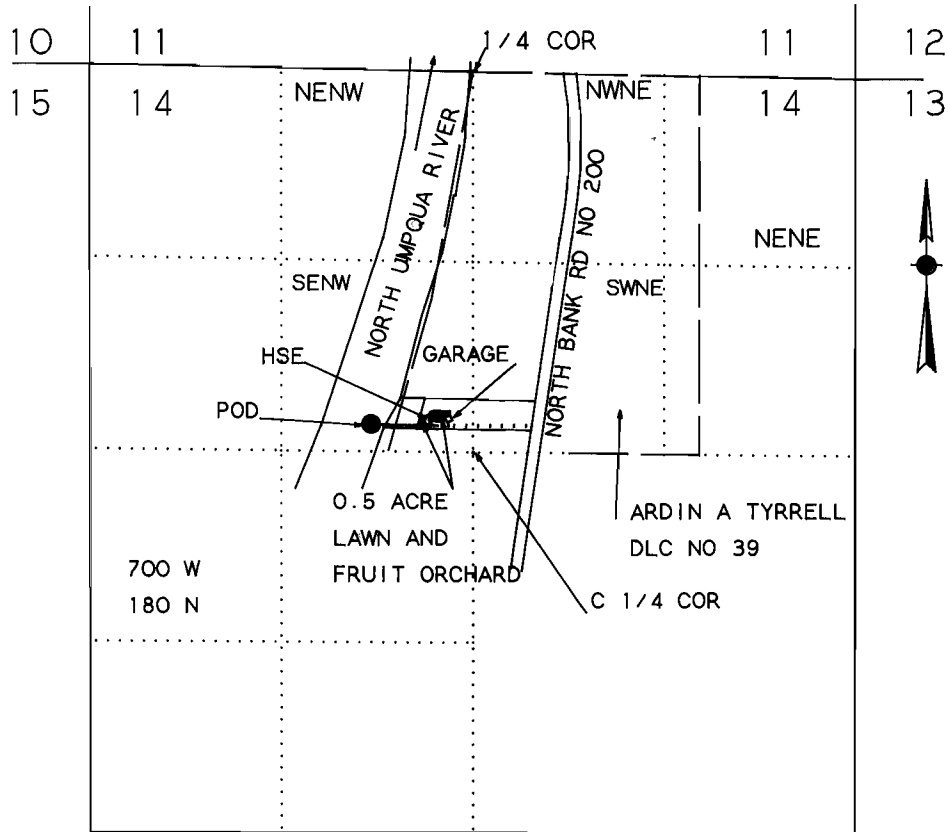

POD IS 180 FT N AND 700 FT W FROM C 1/4 SEC 14

FINAL PROOF SURVEY


UNDER

Application No. 69332 Permit No. 50165

IN NAME OF

JON HARRISON

Surveyed January 24, 1991 by M.E. FARR

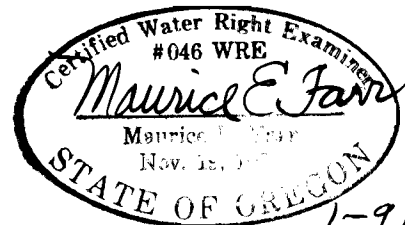

1-91