


FINAL PROOF SURVEY OF PERMIT TO  
 APPROPRIATE THE PUBLIC WATERS IN THE SW 1/4 NW 1/4  
 OF SECTION 24, T.23 S., R.13 W., W.M., COOS COUNTY, OREGON

APPLICATION NO. 69439

PERMIT NO. 50429

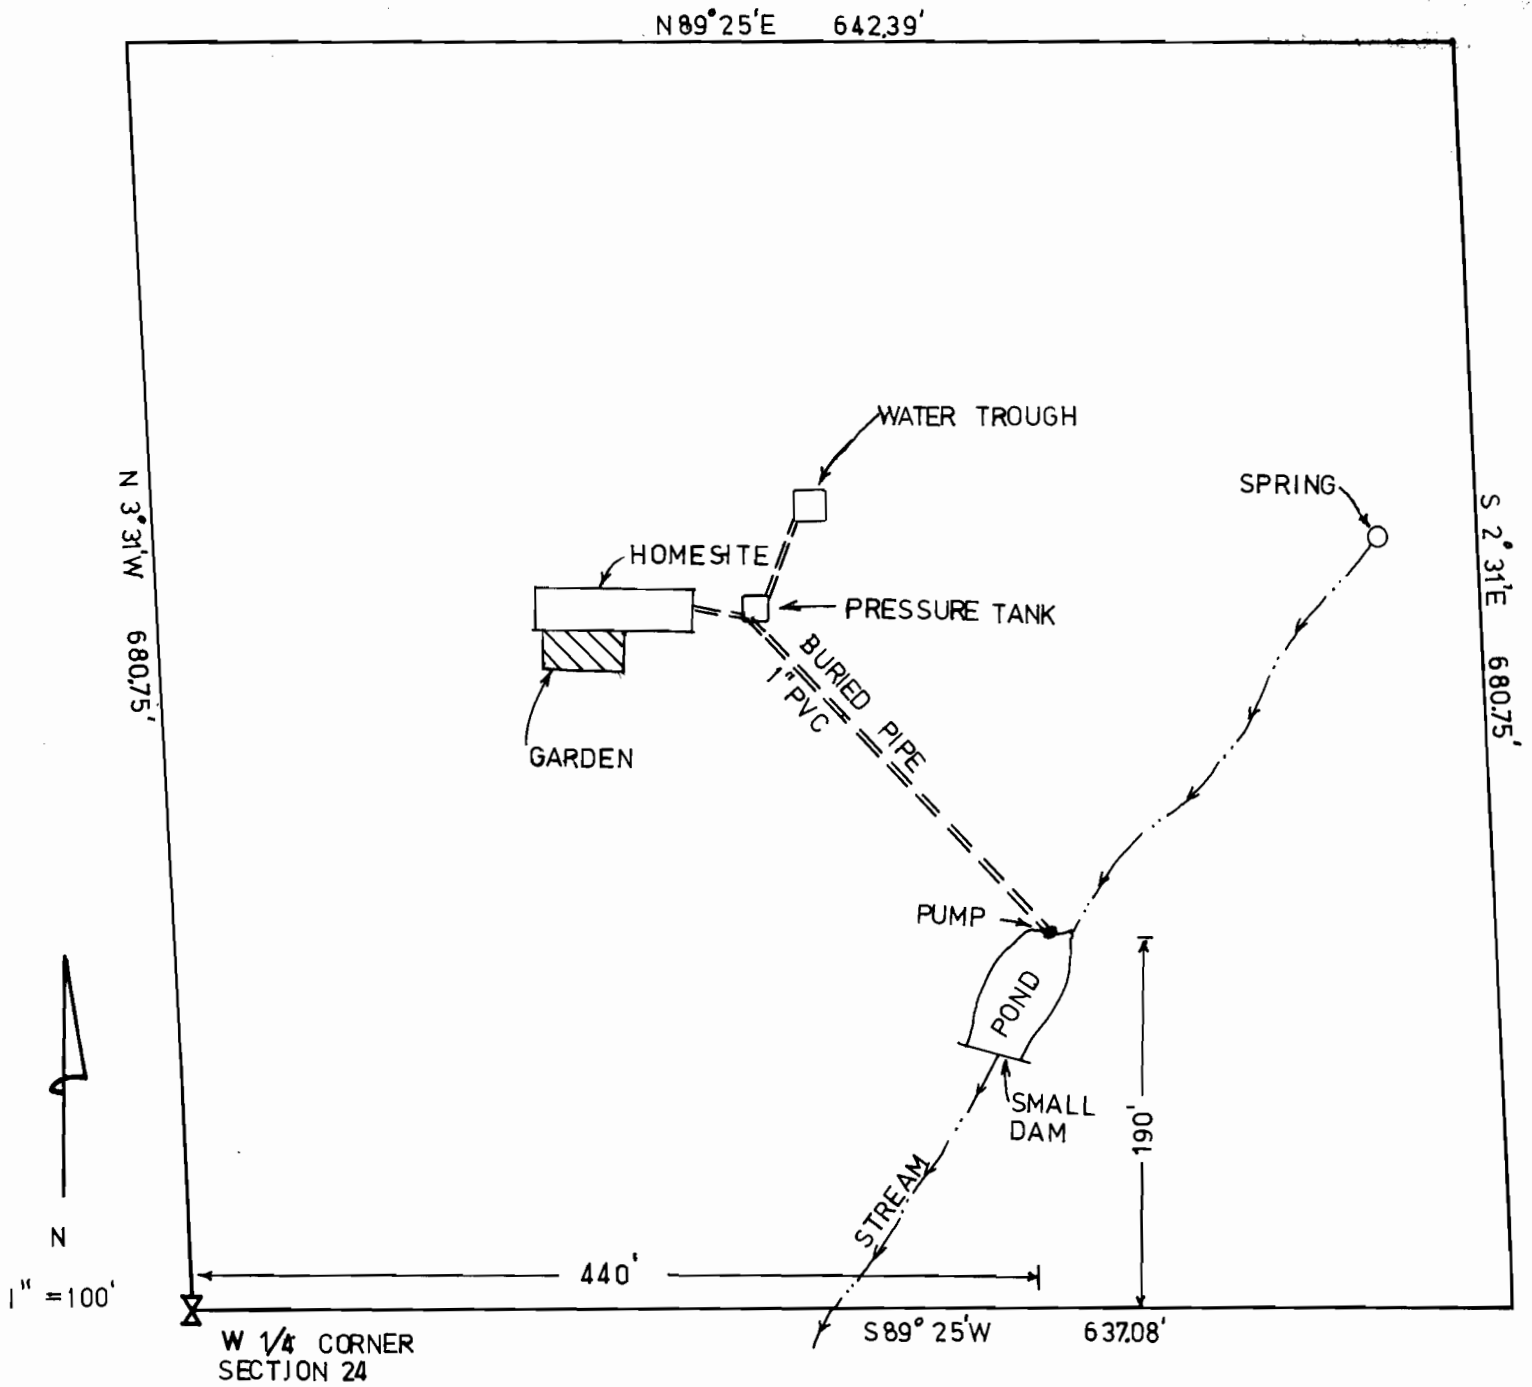

FOR: SHELLY MACMANIMAN  
 694 LASKEY LANE  
 NORTH BEND, OR., 97459

BY: KEITH COMSTOCK  
 27116 HIGHWAY 38  
 ELKTON, OR., 97436

