


G341

# T. 2 N. R. 12 E. W. M

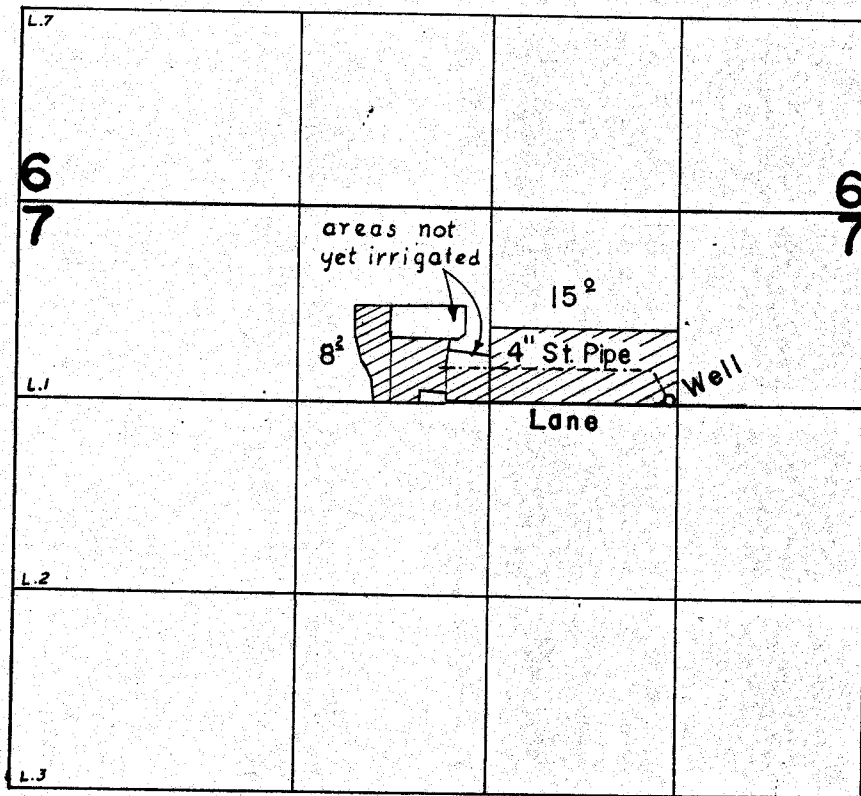

## FINAL PROOF SURVEY UNDER

Application No. G-423. Permit No. G-341  
IN NAME OF

**CLYDE A. ROOT**

Surveyed April 2, 1962, by *S. W. Gebusck*

Dist. 3-1962-A