


T. 9 S. R. 5 W. W. M.

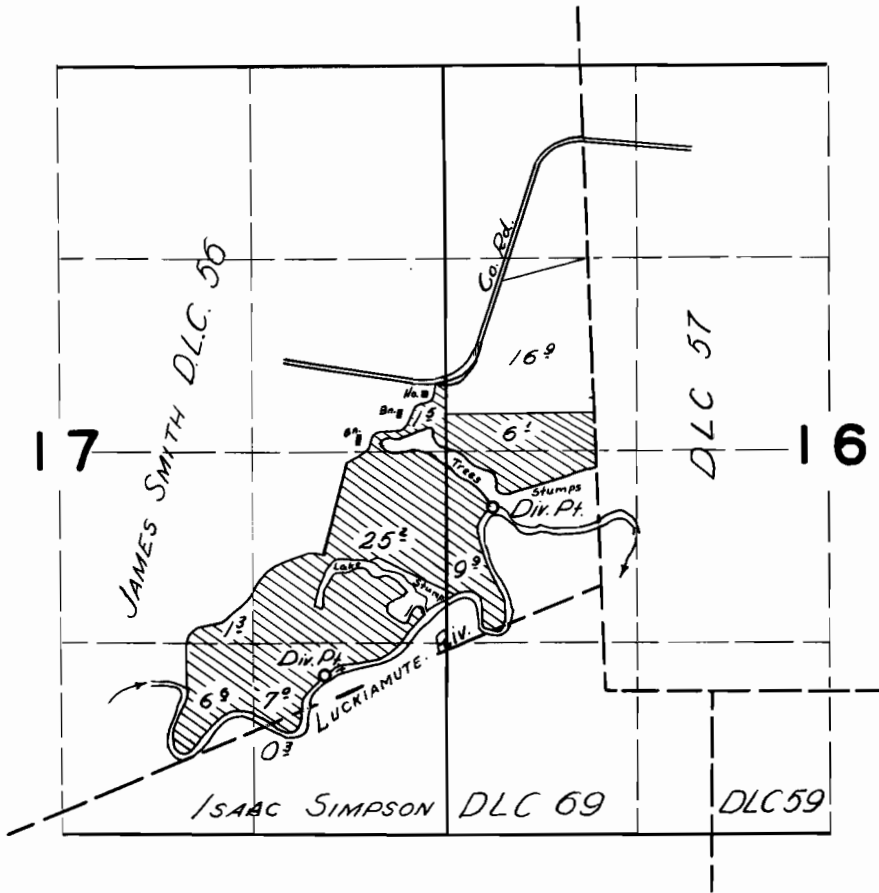

FINAL PROOF SURVEY
UNDER

Application No. 24190 Permit No. 19639

IN NAME OF

VERN C. OSBORN

Surveyed 27 Mar. 1957, by [Signature]