


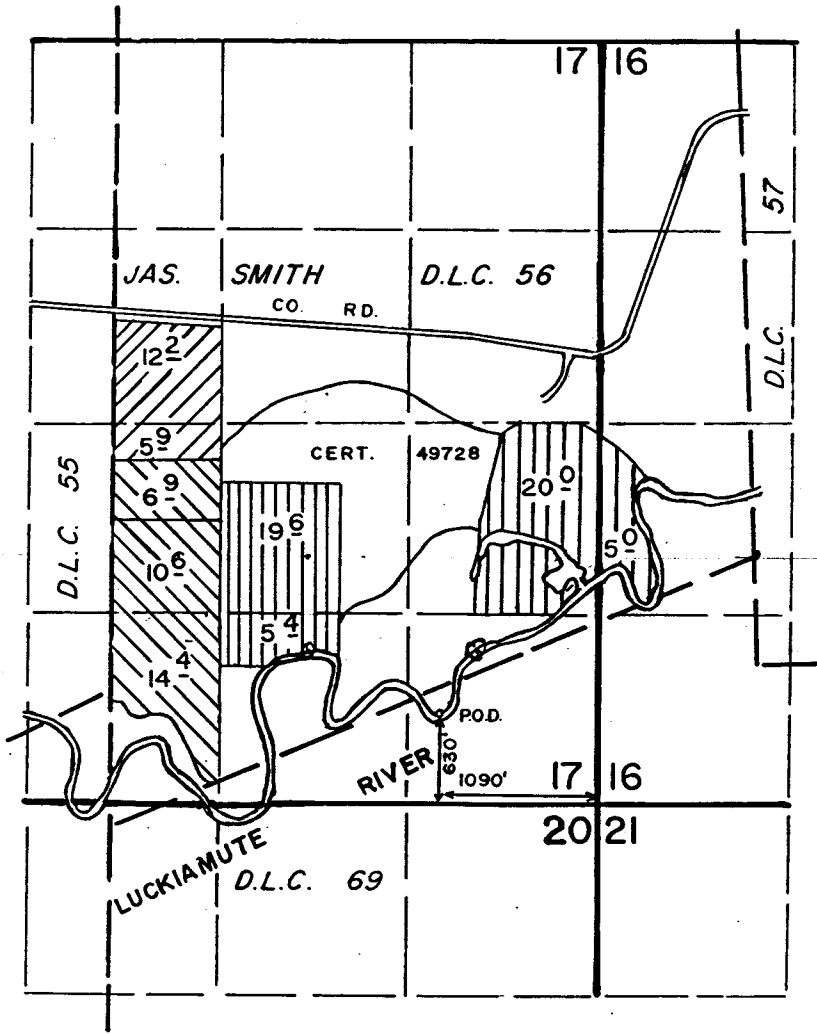


T. 9 S., R. 5 W., W.M.



1" = 1320'

-  T 4506 priority 5-12-69
-  T 4507
T 4505 priority 1-27-65
-  T 4504 priority 10-26-50

FINAL PROOF SURVEY
UNDER

TRANSFER NO. 4504, 4505, 4506, 4507

Application No. Permit No.
IN NAME OF

DESSERT SEED CO.

Surveyed **MAY 11** 19**87**, by **B.W. BISHOP**

10-3-90
DFP-2P-7
41053-178-203D