


T. 9 S., R. 5 W., W.M.

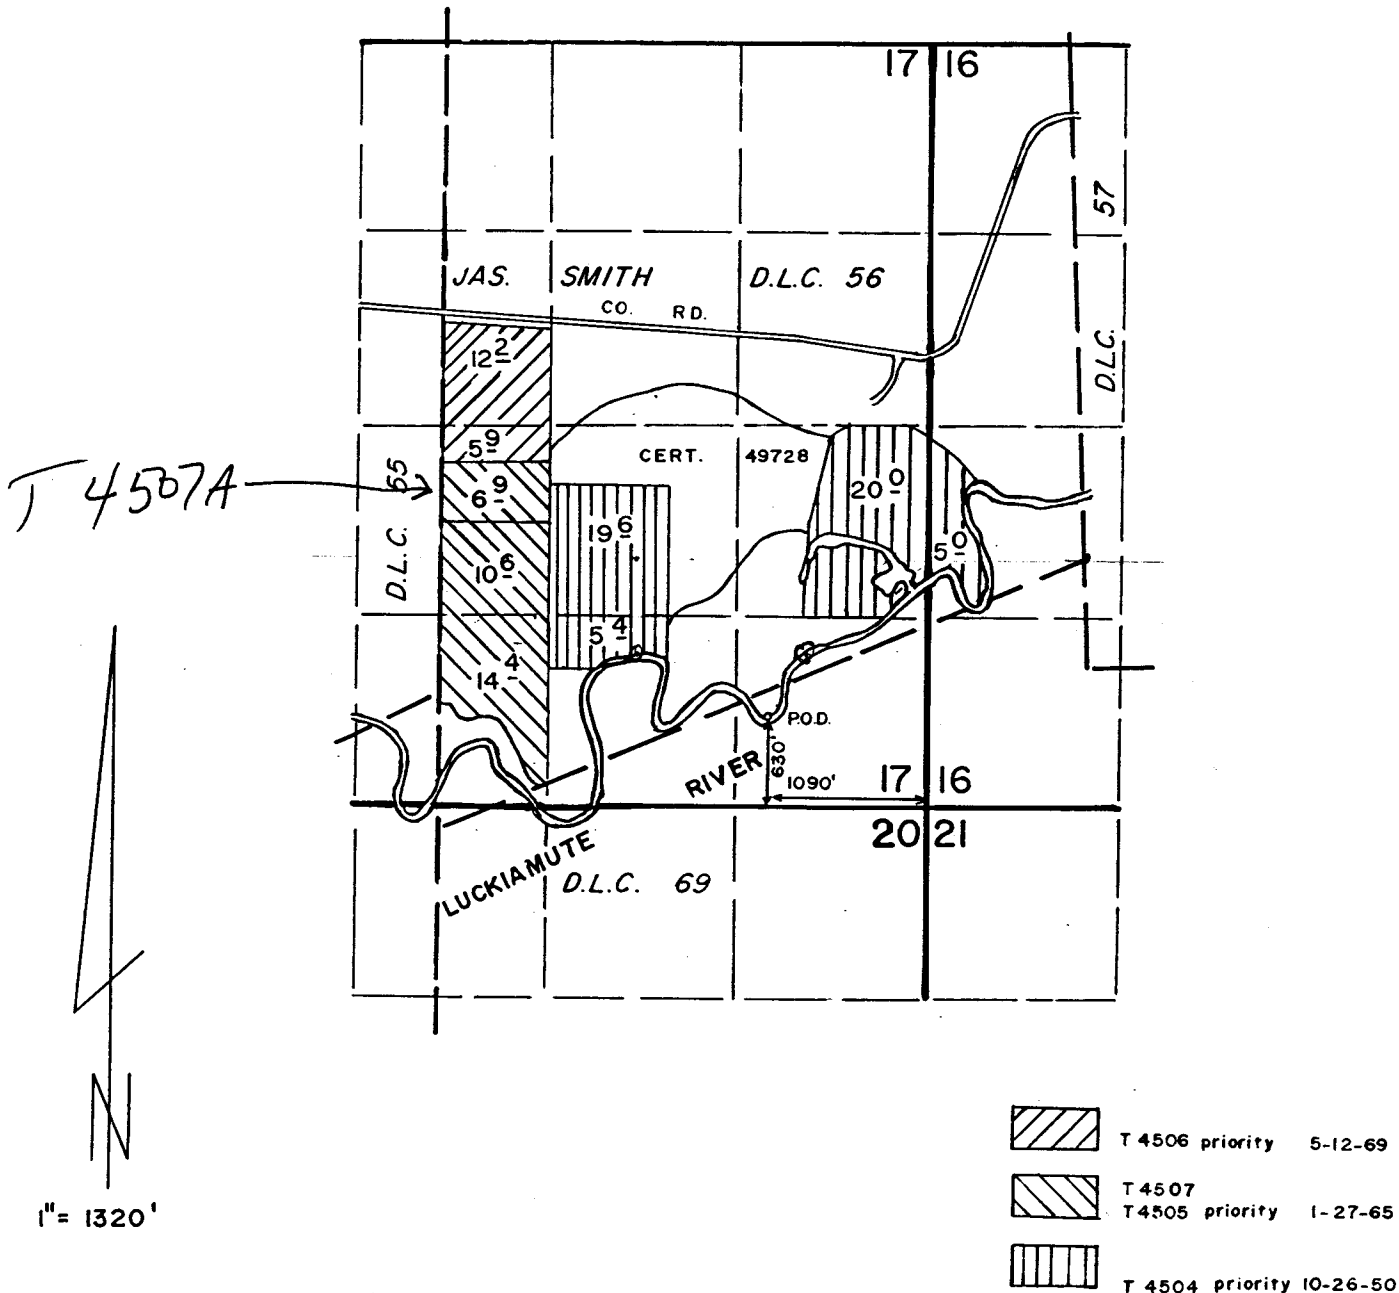

FINAL PROOF SURVEY UNDER

TRANSFER NO. 4504, 4505, 4506, 4507

Application No. Permit No.
IN NAME OF

DESSERT SEED CO.

Surveyed MAY 11 1987, by B.W. BISHOP

10-3-90
DFP-2P-7
41053-178-203D