


T.9S.R.5W.W.M.

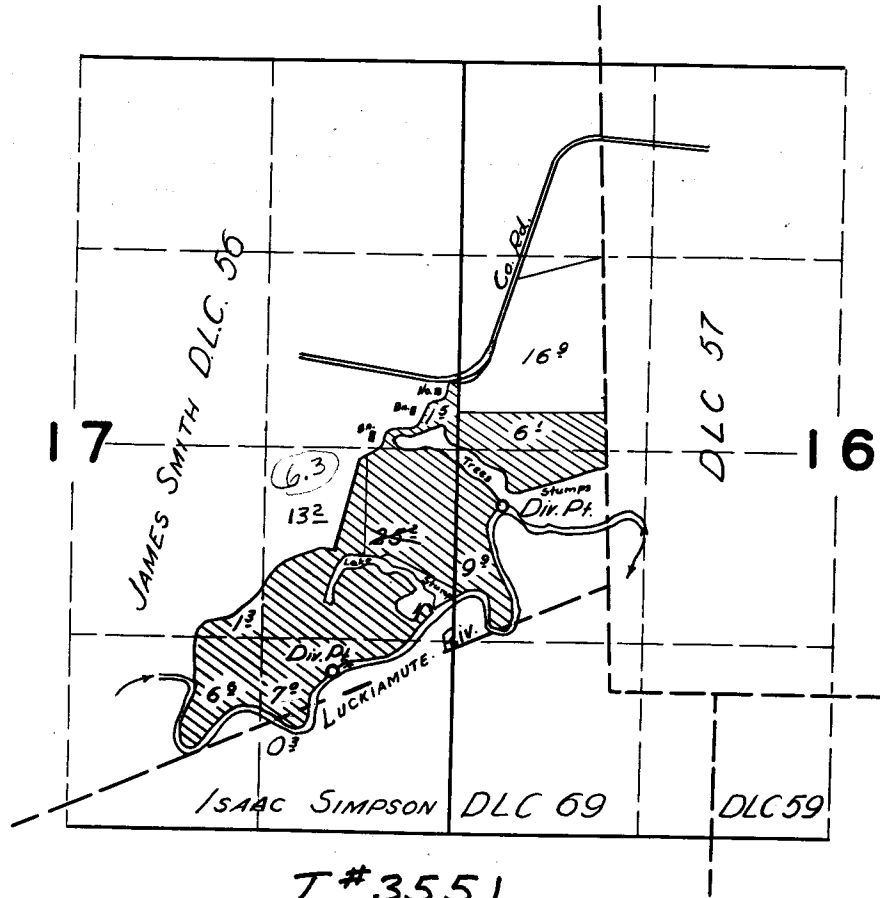

T#3551

"To"

~~FINAL PROOF SURVEY  
UNDER~~

~~Application No. 2190 Permit No. 19639  
IN NAME OF~~

~~WERN C. OSBORN~~

~~Surveyed 27 Mar. 1957, by *W. C. Osborn*~~