


# T. 34S. R. 7E. W.M.

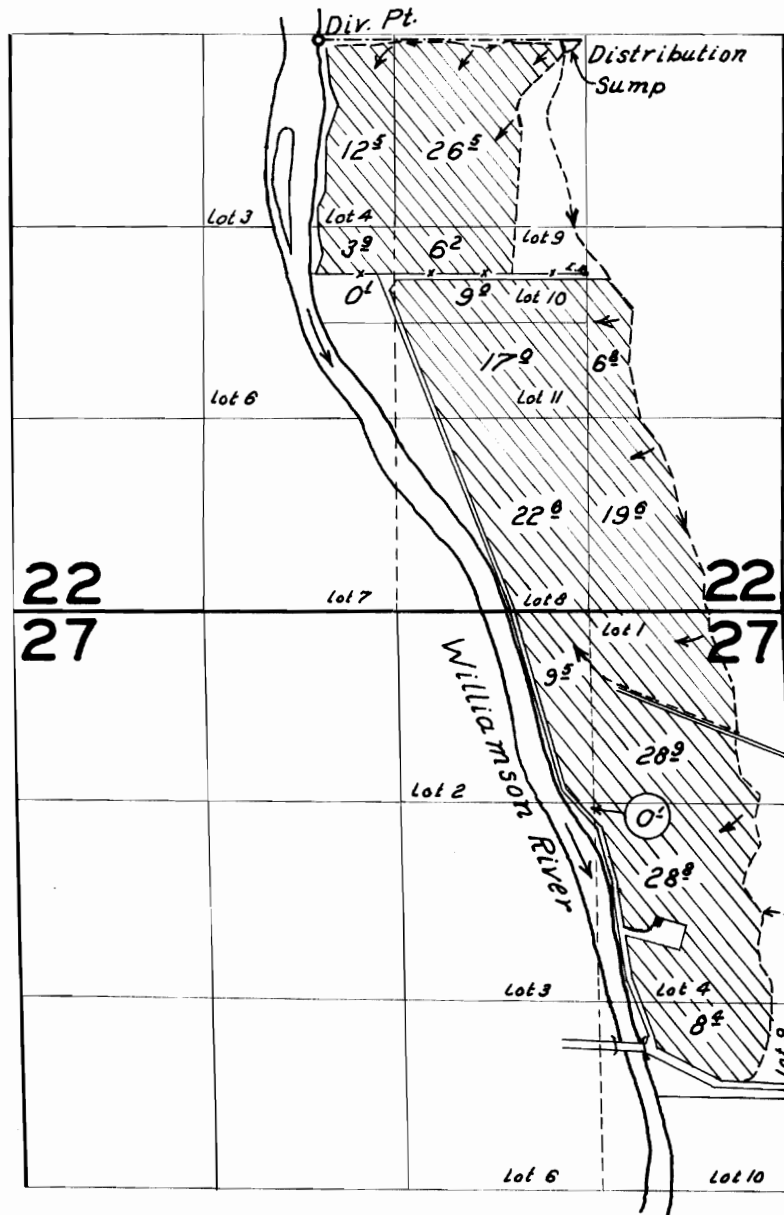

FINAL PROOF SURVEY

UNDER

APPROVED 30/06 23654

Ned Putnam

Surveyed Oct. 26 1859 by R. H. Jackson