


T.8S., R.39E., W.M.

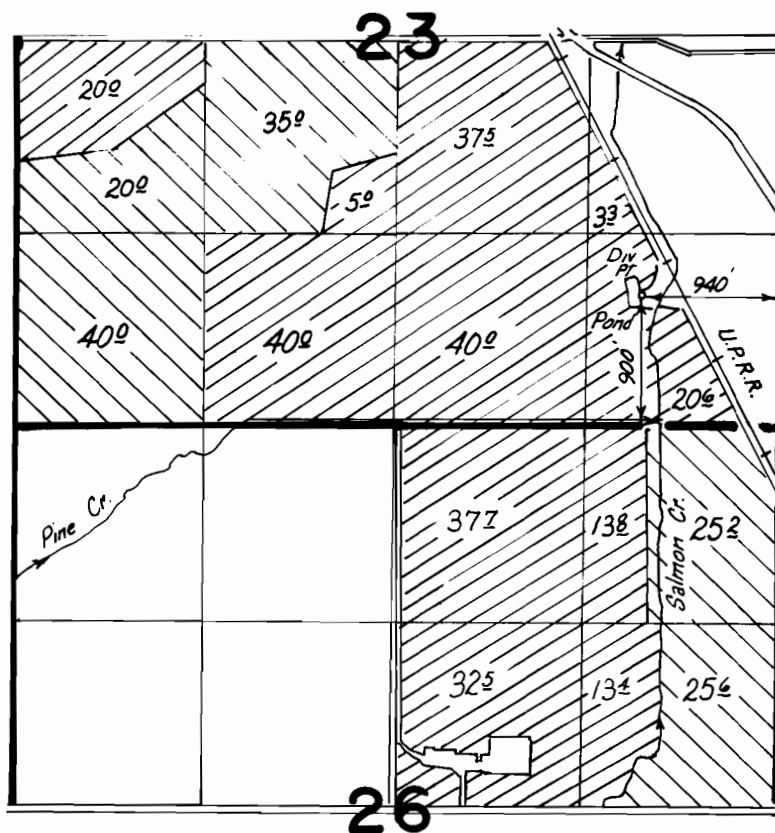

FINAL PROOF SURVEY
UNDER

Scale: 1" = 1320'

Application No. G.6514.. Permit No. G.6126....
IN NAME OF

.....LAWRENCE JEPSON & SON'S.....

Surveyed 8-5..... 1981.., by Vern Church.....



Primary



Supplemental