


T.24S., R.5 W., W.M.

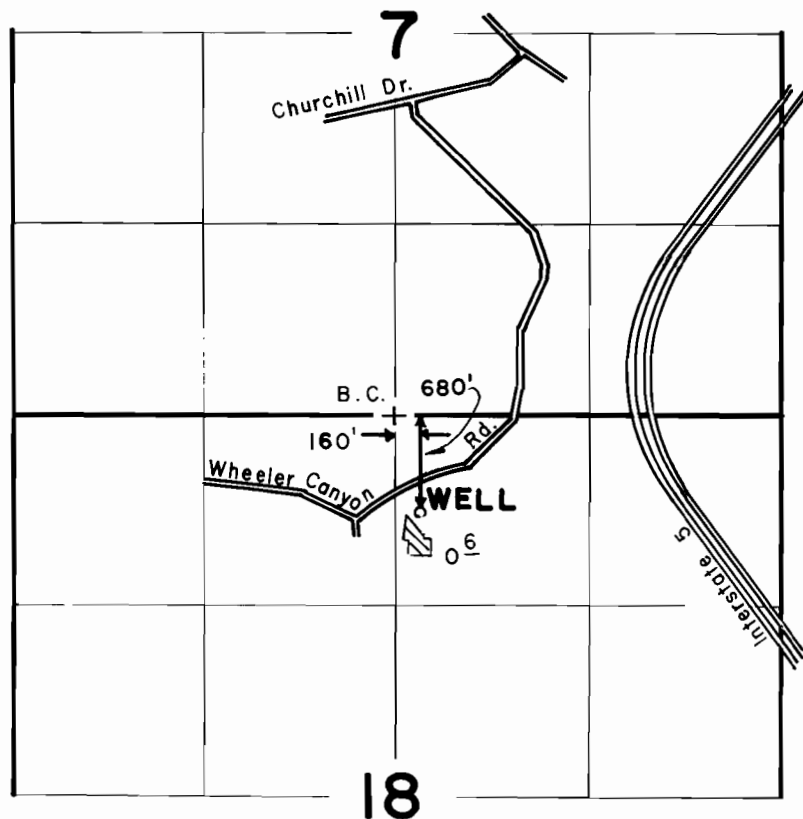

SCALE: 4" = 1 MILE

FINAL PROOF SURVEY
UNDER

Application No. **G-7667** Permit No. **G-7104**
IN NAME OF

Sherman Reid

Surveyed **OCT. 15 86** by **J. M. SCHMORDE**
May 19 80, by **J. S. Donaldson**