


# T.5S. R.3W. W.M.

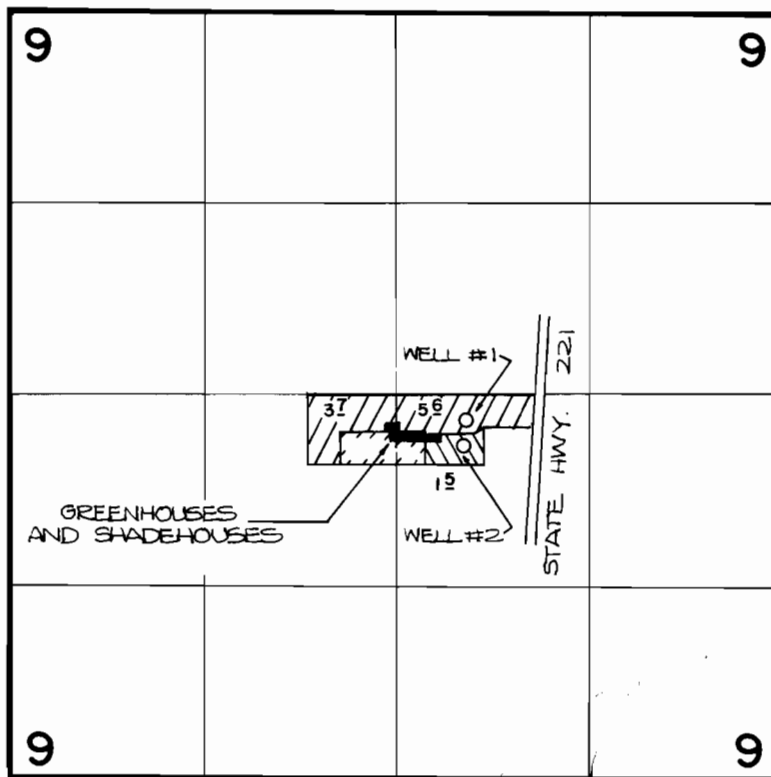


WELL #1 IS LOCATED 190' S. AND 3150' W.; WELL #2 IS LOCATED 350' S. AND 3110' W., BOTH FROM THE E. 1/4 CORNER OF SECTION 9.



PRIMARY



SUPPLEMENTAL

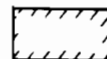

CONTAINER STOCK

## FINAL PROOF SURVEY UNDER

Application No. G-7.9.2.5 Permit No. G-9.7.4.0...  
IN NAME OF

CHARLES KOZELL

Surveyed OCT. 21, 1983, by P. P. P. P.