


T.17S. R.3W. W.M.

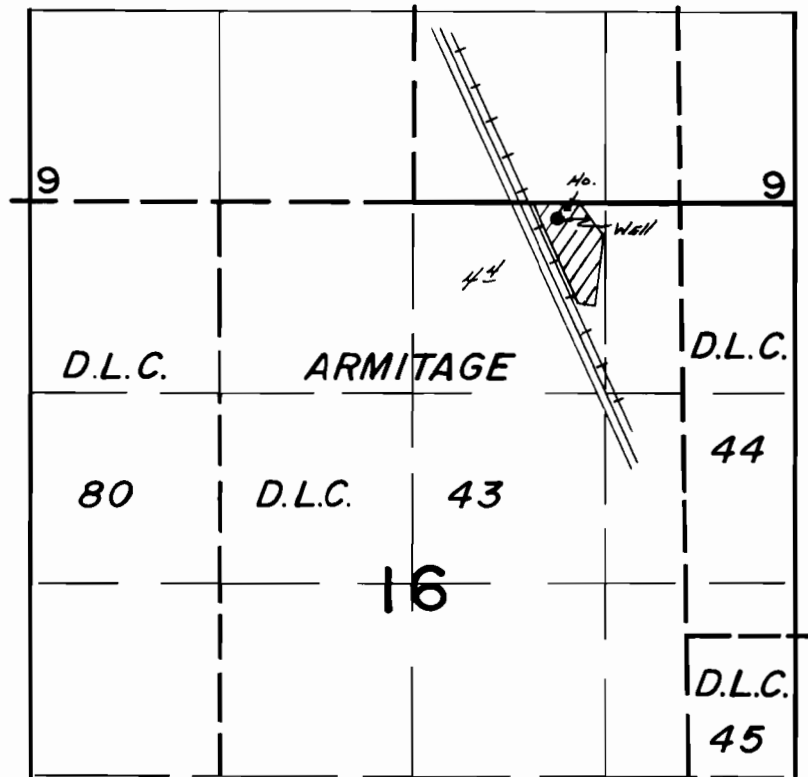

Well Loc. - 100' S & 1000' E from N¹/₄ Cor. Sec. 16

FINAL PROOF SURVEY

UNDER

Application No. ~~G-8166~~ Permit No. G-7520
IN NAME OF

JAN. WOSTMANN

Surveyed Oct...12.. 1979, by C.R.RODRIGUEZ