



T. 16 S., R. 43 E., W. M.

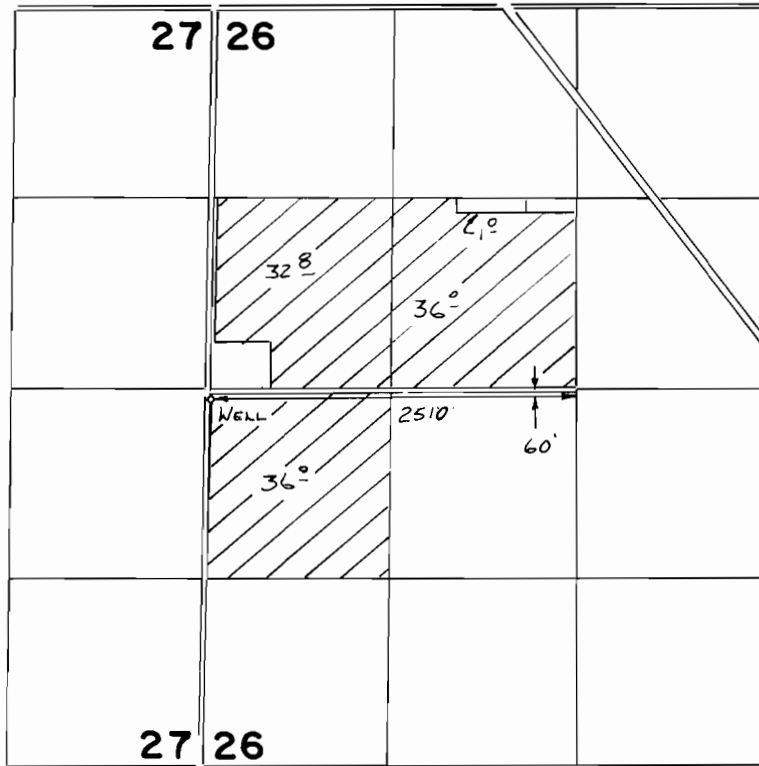


 SCALE 1" = 1320'

FINAL PROOF SURVEY UNDER

Application No. **G-8375** Permit No. **G-7758**
 IN NAME OF

..... **THEO TAGHON**

Surveyed 6-19 1986, by V.L. Church