


T. 40 S., R. 12 E., W.M.

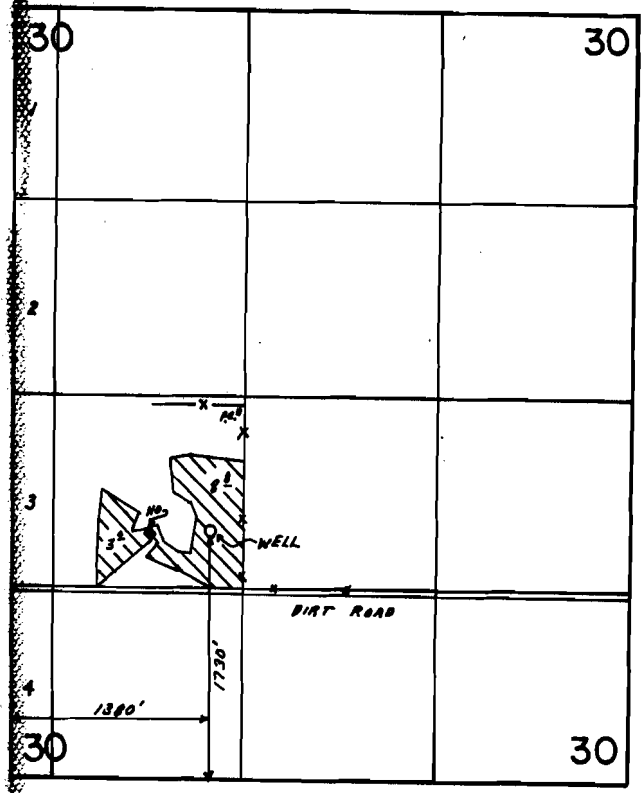

SCALE: 1"=1320'

FINAL PROOF SURVEY
UNDER

Application No. G-9516 [REDACTED]
IN NAME OF

ALBERT BYRON ROSS

Surveyed AUG. 20 1987, by V.L. CHURCH