


219504

T. 5N., R. 26E., W.M.

SE 1/4 NE 1/4 SEC. 25  
SCALE 1" = 400'

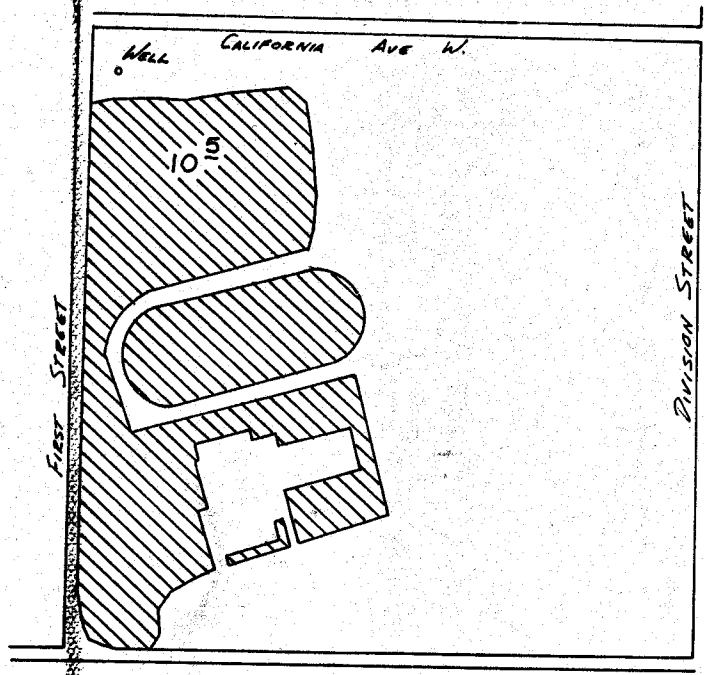

Well LOCATED 1220' N. + 1240' W. FROM E 1/4 COR SEC 25

**FINAL PROOF SURVEY**  
UNDER

Application No. **G:9847**. Permit No. **G:9504**.  
IN NAME OF

**MORROW COUNTY SCHOOL DIST.**

Surveyed **10-26** 19**83**, by **V.H. Church**