


T.1S., R.14E., W.M.

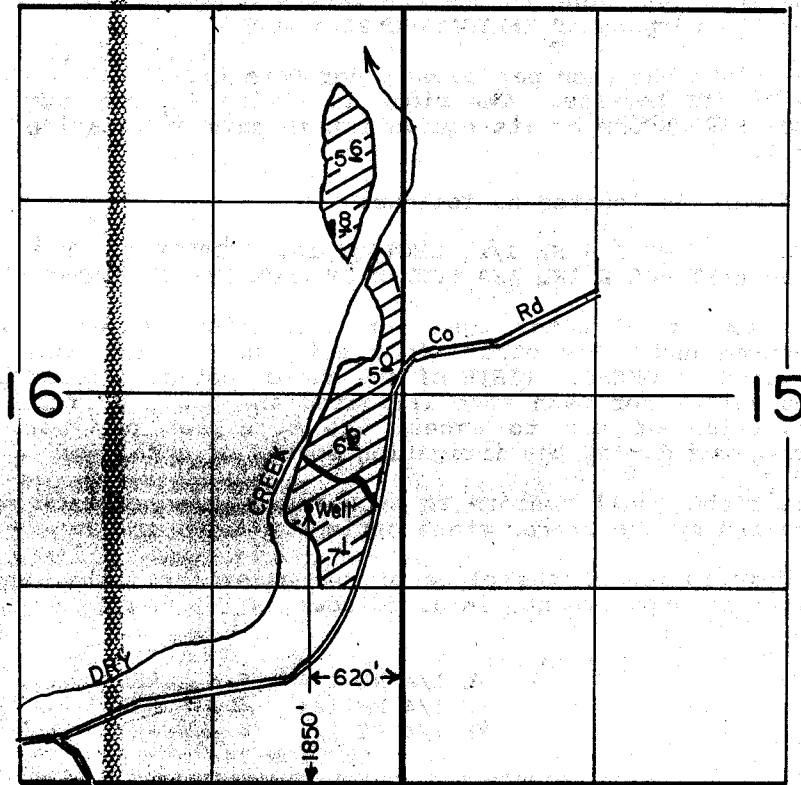

SCALE: 1" = 1320'

**FINAL PROOF SURVEY**  
UNDER

Application No. G-9906.. Permit No. G-9511.....  
IN NAME OF

**WILLIAM L. & DANIEL L. BOLTON**.....

Surveyed AUG. 12.. 1987., by V.L. CHURCH.....