
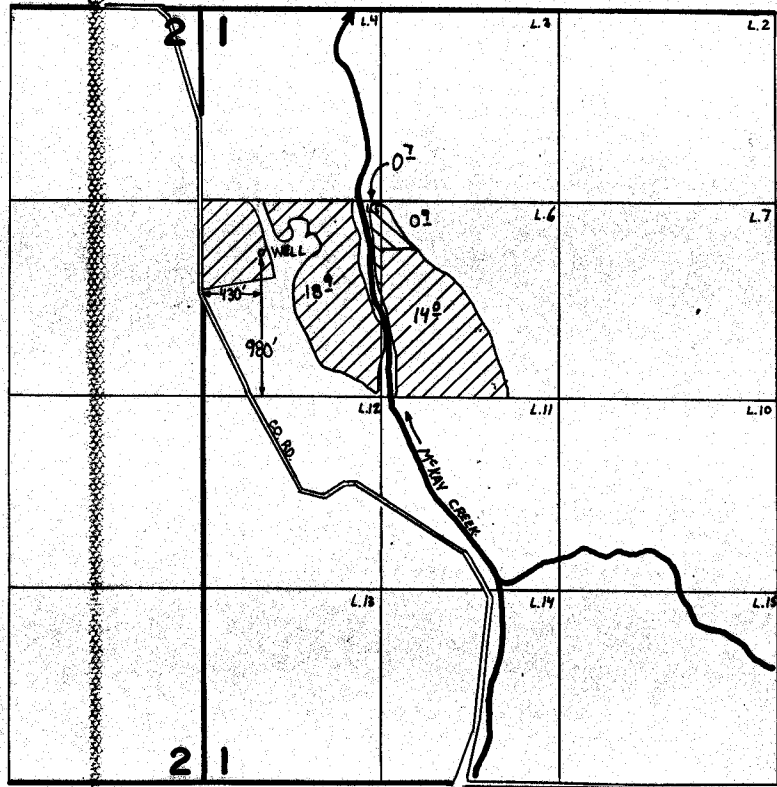


T 1 S. R. 32 E. W.M.

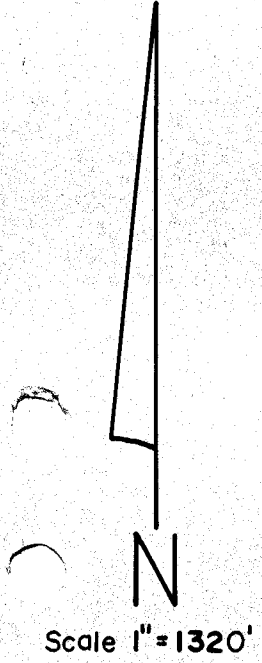

FINAL PROOF SURVEY UNDER

Application No. G.9950 Permit No. G.9590.....
IN NAME OF

.....**CHARLES E. JOHNSTON**.....

Surveyed June 30, 1986, by J. Sauter.....