



T.2N.R.20E.W.M.

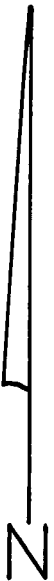

Scale 1"=1320'

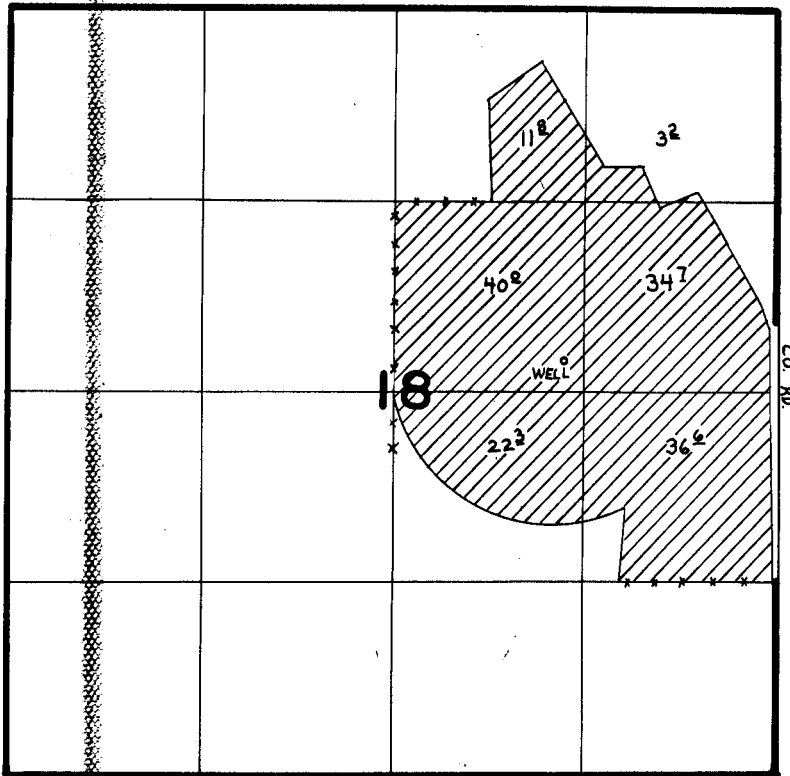

WELL LOC. 2430' S. of 1170' E. FROM N. 44 COR. SEC. 18

FINAL PROOF SURVEY UNDER

Application No. G9969 Permit No. G9625
IN NAME OF

CHARLES G. REEVES

Surveyed May 13, 1986, by V. Church