


T2N, R14E, WM

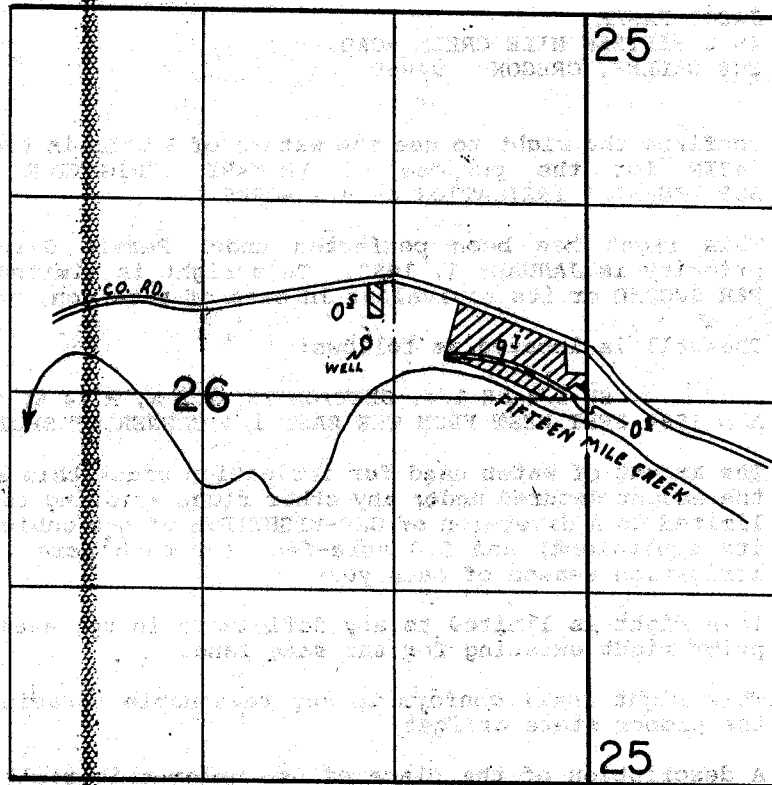

SCALE:
1" = 1320'

WELL LOCATION: 400 N AND 1580 W FROM THE E/W CORNER SECTION 26

 PRIMARY IRR.

 SUPPLEMENTAL IRR.

FINAL PROOF SURVEY UNDER

Application No. G-10860 Permit No. G-10010...
IN NAME OF

JACOB KASER

Surveyed APRIL 13, 1988, by T.M. WARREN...