


2f-10072
65777

T. 4N., R. 35E., W.M.

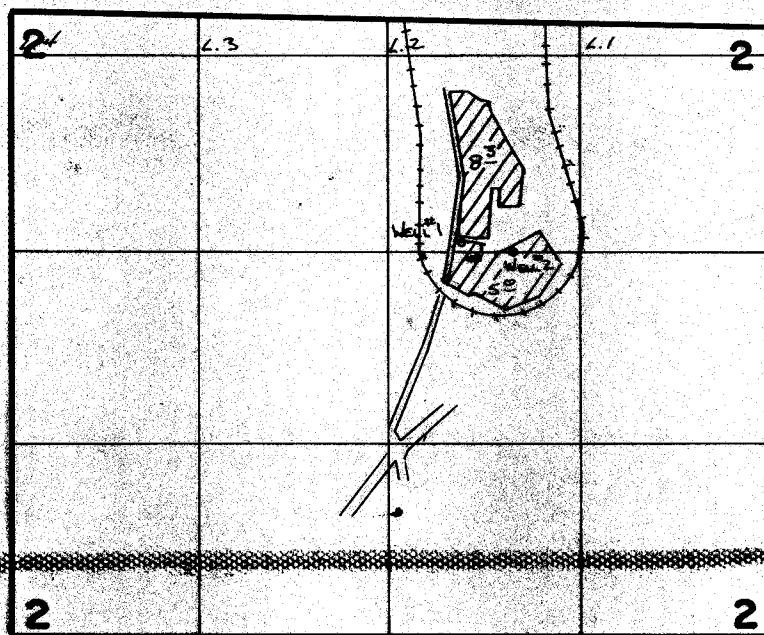

Well #1 Loc: 60' N. & 510' E. FROM CENTER COR. SEC 2

Well #2 Loc: 870' E FROM CENTER COR. SEC 2

SCALE 1" = 1320'

FINAL PROOF SURVEY

UNDER

Application No. **G-10866** Permit No. **G-10072**
IN NAME OF

HANSELL FARMS INC.

Surveyed 3-13-1985, by V.L. Church