


T. 39S., R. 8E., W.M.

6-10014
65778

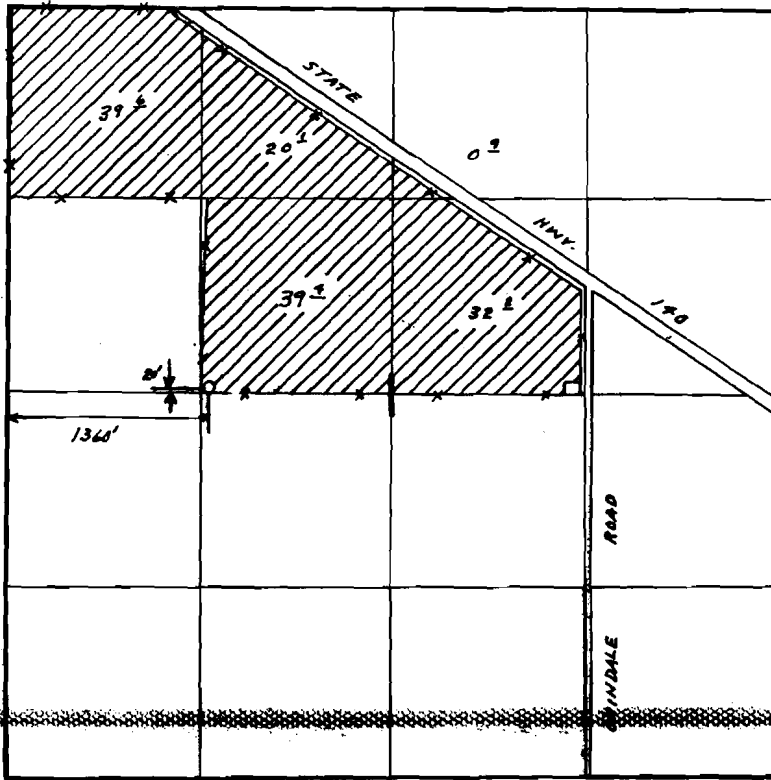

SCALE: 1"=1320'

FINAL PROOF SURVEY
UNDER

Application No. G-10881 Permit No. [REDACTED]
IN NAME OF

EDGAR J. BLODGETT

Surveyed AUG. 20, 1987., by R. S. JAMES

1-17-89

Photo 1-0083-A

R.S.C.

