


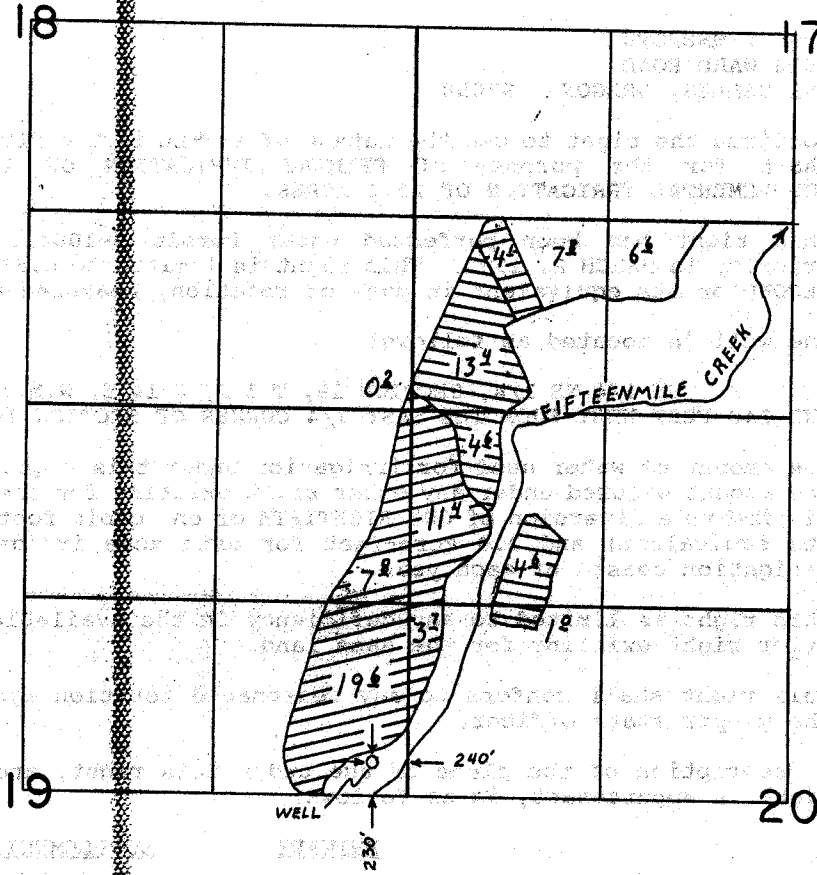

TIS, R14E, WM



1" = 1320'

-  PRIMARY IRRIGATION
-  SUPPLEMENTAL IRRIGATION

FINAL PROOF SURVEY UNDER

Application No. G-10890 Permit No. G-10041....
IN NAME OF

.....PAUL LIMMEROOTH.....

Surveyed JUNE...7... 1988, by T.M. WARREN...

RLK
41065 179 119R