


G-10266
65781

T.26&27S., R.19E., W.M.

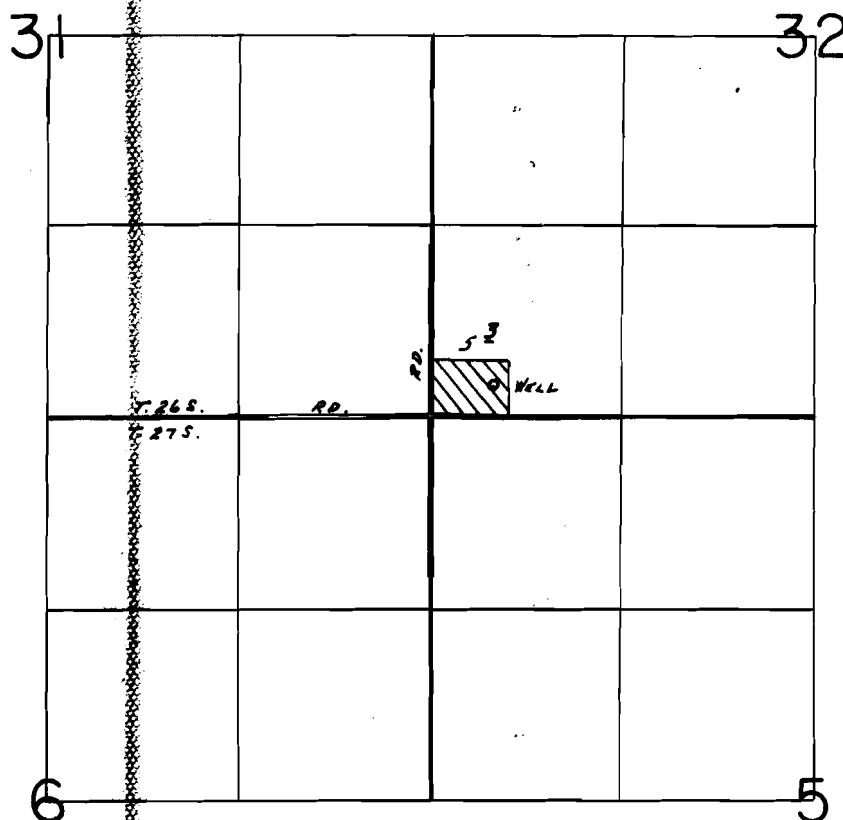

Well loc.: 220' N. & 430' E. FROM SW COR. SEC. 32.

SCALE: 1" = 1320'

FINAL PROOF SURVEY UNDER

Application No. G-11147.. Permit No. G-10266...
IN NAME OF

...ROBERT H. or MARION M. SAMS.

Surveyed June 8... 19.88., by B.W. BISHOP....

1/17/89
BWB

41037-379-242A