


T. 32 S., R. 5 W., W.M.

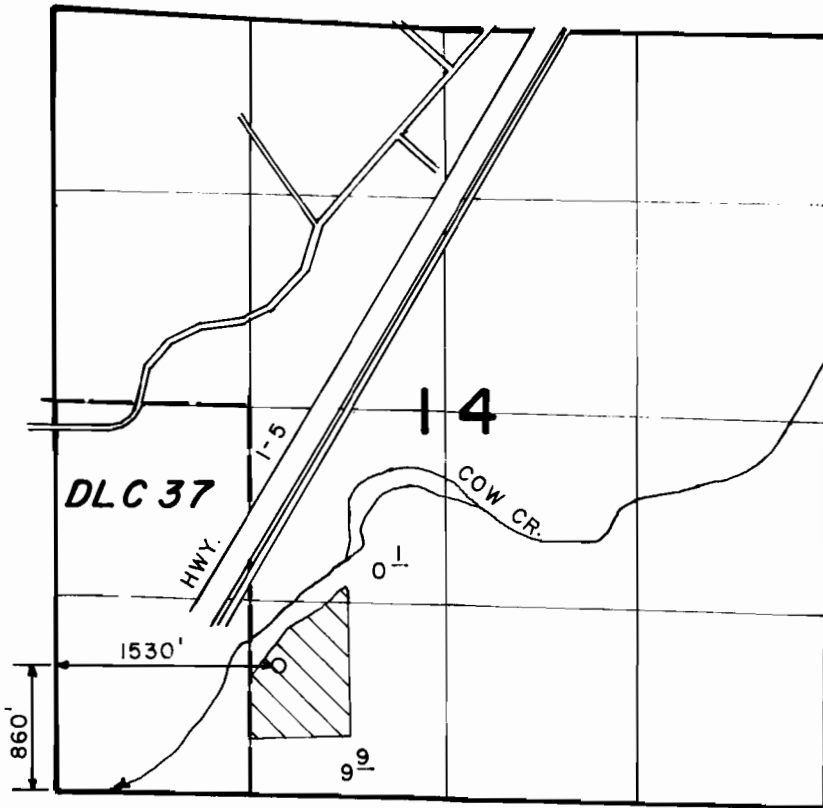

SCALE: 4" = 1 MILE

**FINAL PROOF SURVEY**  
UNDER

Application No. G-11149 Permit No. G-10267

IN NAME OF

DAVID J. GALLOWAY

Surveyed JULY 7, 1988, by J.M. SCHMORDE