


T.1S., R.45E., W.M.

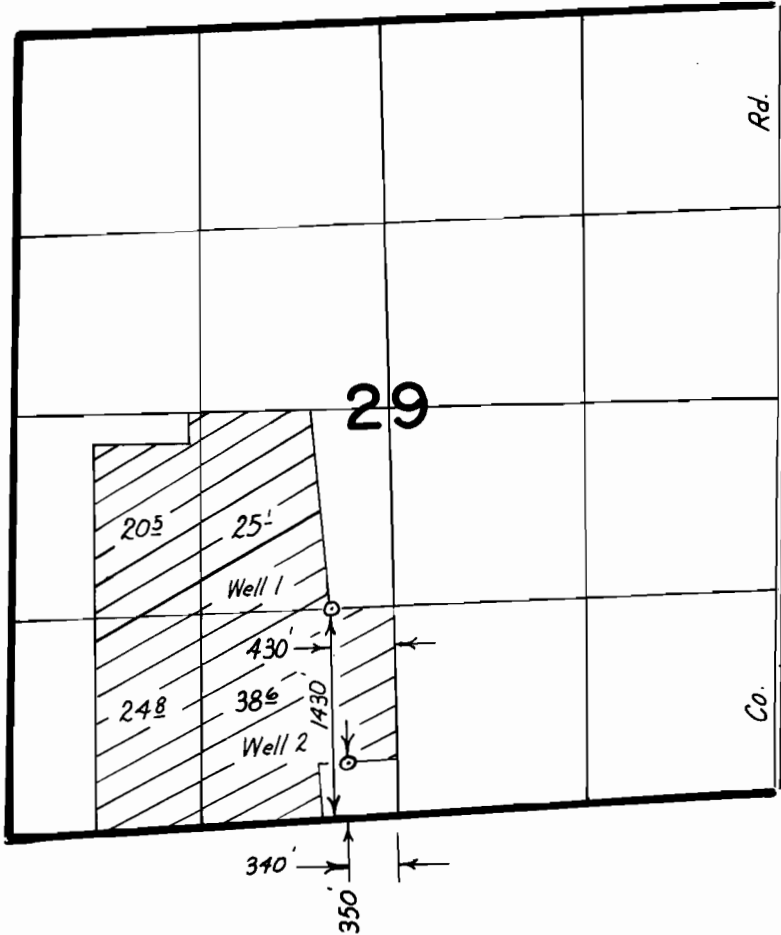

FINAL PROOF SURVEY UNDER



Scale: 1" = 1320'

Application No. G11177 Permit No. G10347
IN NAME OF

LEONARD SKIP MELVILLE

Surveyed 8-16 1988, by Vern Church