


T2N, R11E, WM

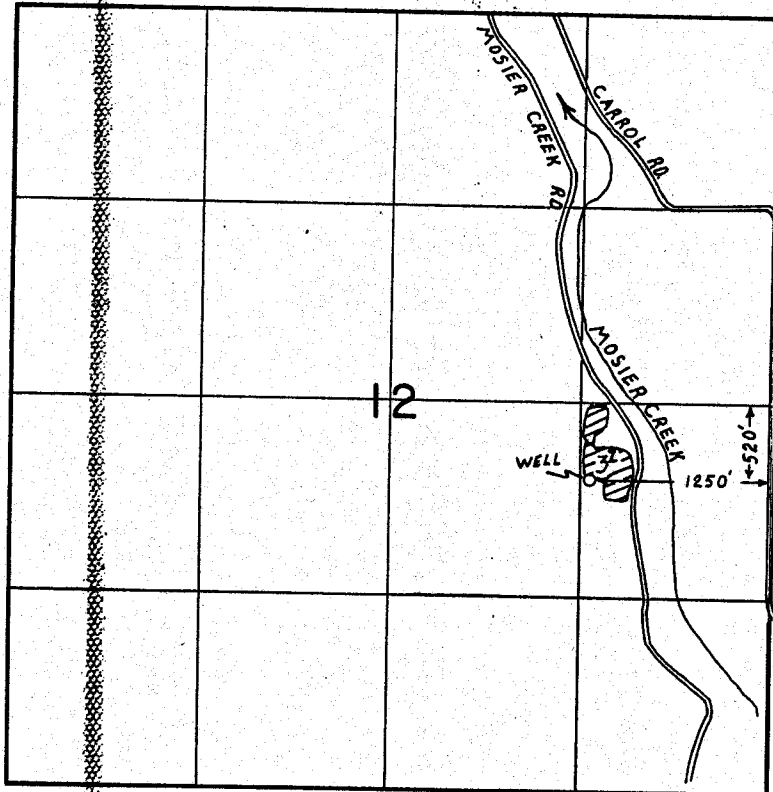

FINAL PROOF SURVEY
UNDER

Application No. G-11180 Permit No. G-10338
IN NAME OF

KENNETH HUDSON

Surveyed APRIL 11, 1988, by T.M. WARREN...

RWK
41065 379 20L