


T. 22 S., R. 32 E., W.M.

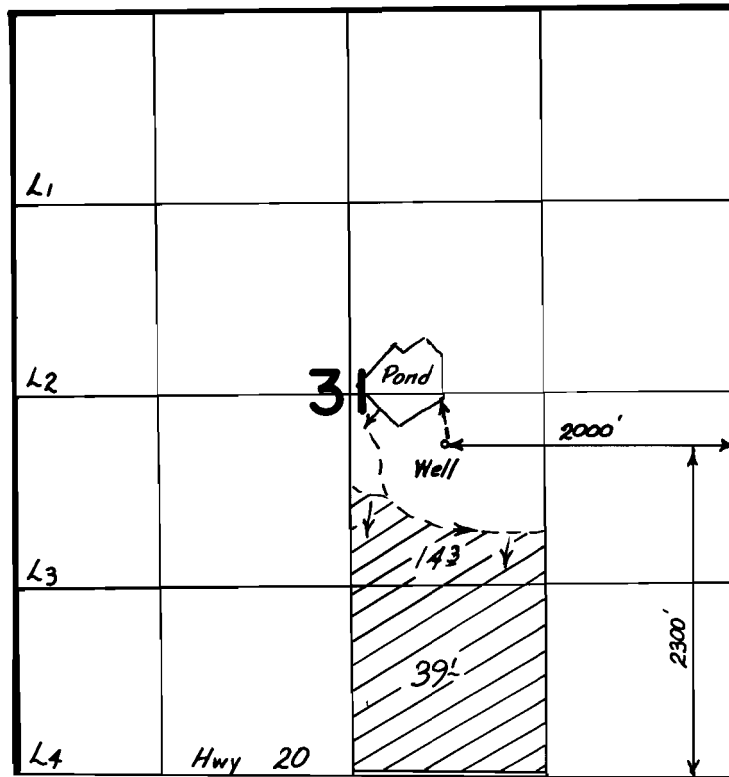

FINAL PROOF SURVEY
UNDER

Application No. G11218 Permit No. G10339
IN NAME OF

JETT C. BLACKBURN

Surveyed 5-10 1988, by Mike Schmarda