



T. 23S., R. 32E., W.M.

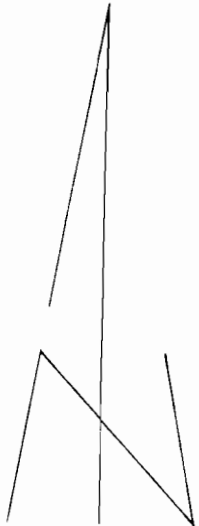

SCALE 1" = 1320'

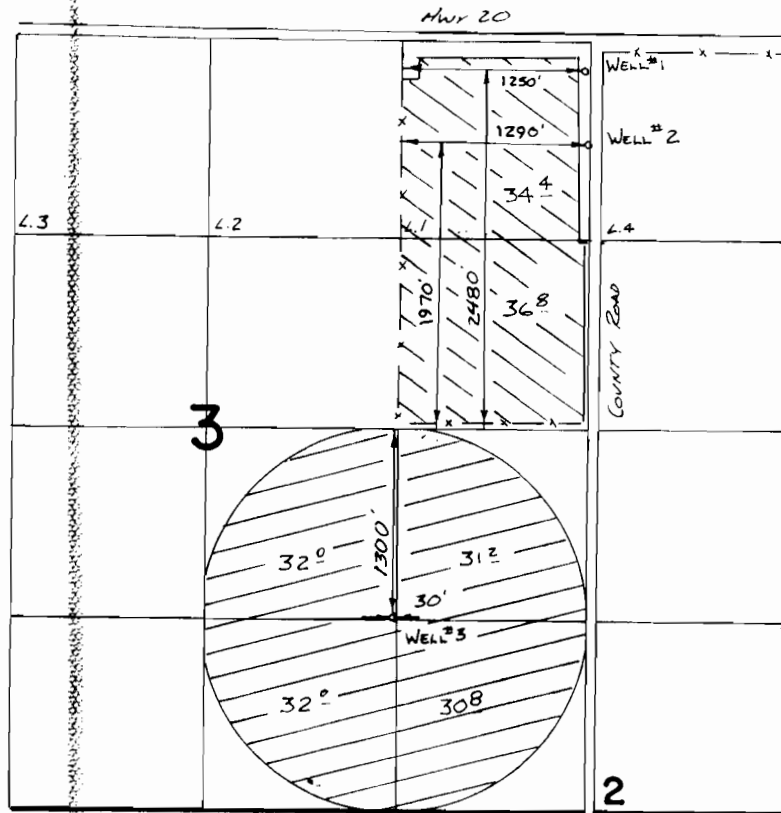

PER. G-10243



PER. G-10341

## FINAL PROOF SURVEY

UNDER

Application No. **G-11220** Permit No. **G-10341**  
**G-11104** **G-10243**  
IN NAME OF

**JETT C. BLACKBURN**

Surveyed **5-7** 1988, by **J.M. Schmorde**

41025-179-302

12-20 88