


T. 16S., R. 43E., W.M.

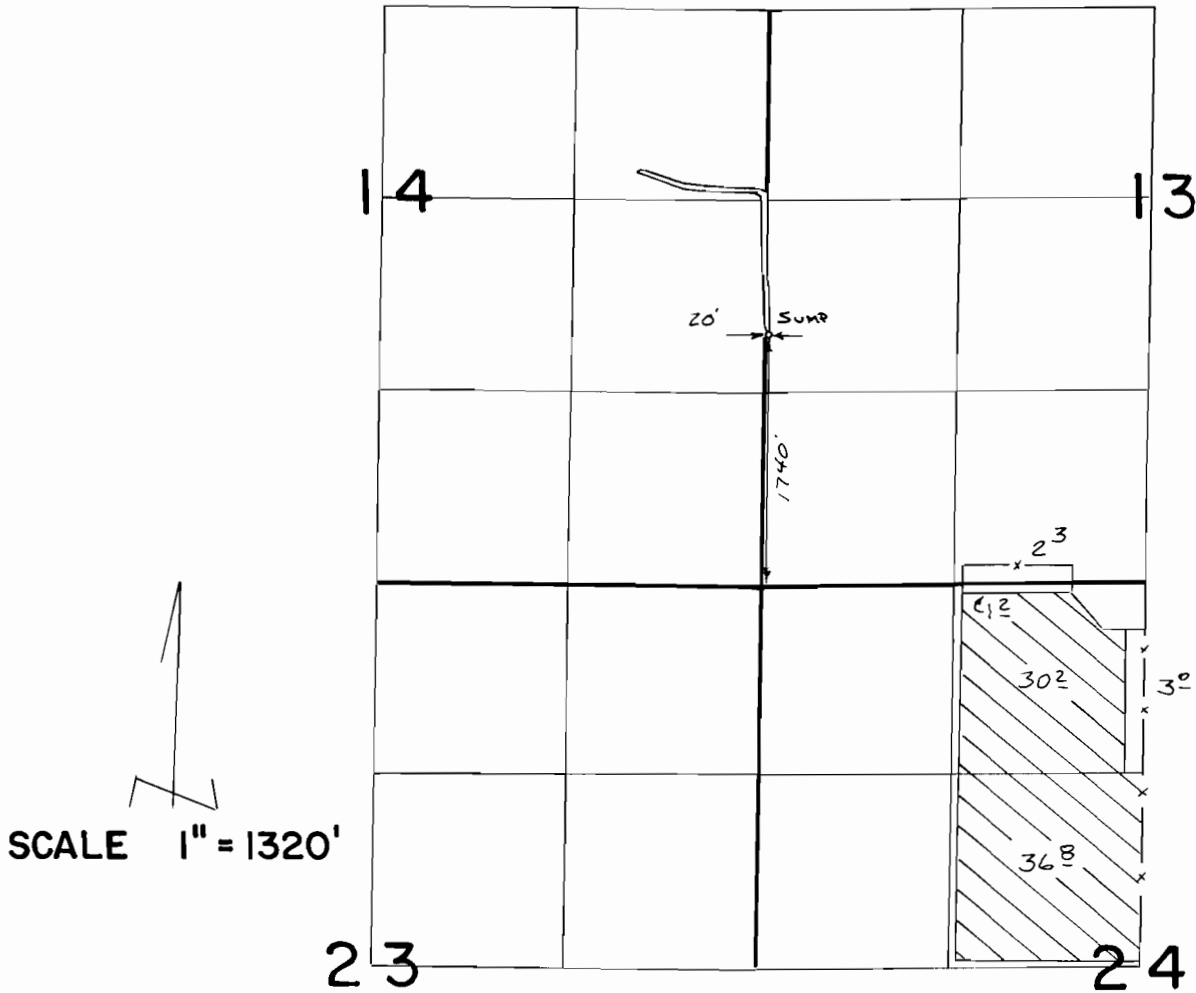

FINAL PROOF SURVEY
UNDER

Application No. **G:11335** Permit No. **G:10467**

IN NAME OF

JOSEPH L. ARRIOLA

Surveyed **10-10** 19**88**, by **V.L. Church**