


210576  
65789

T. 6N., R. 35E., W. M.

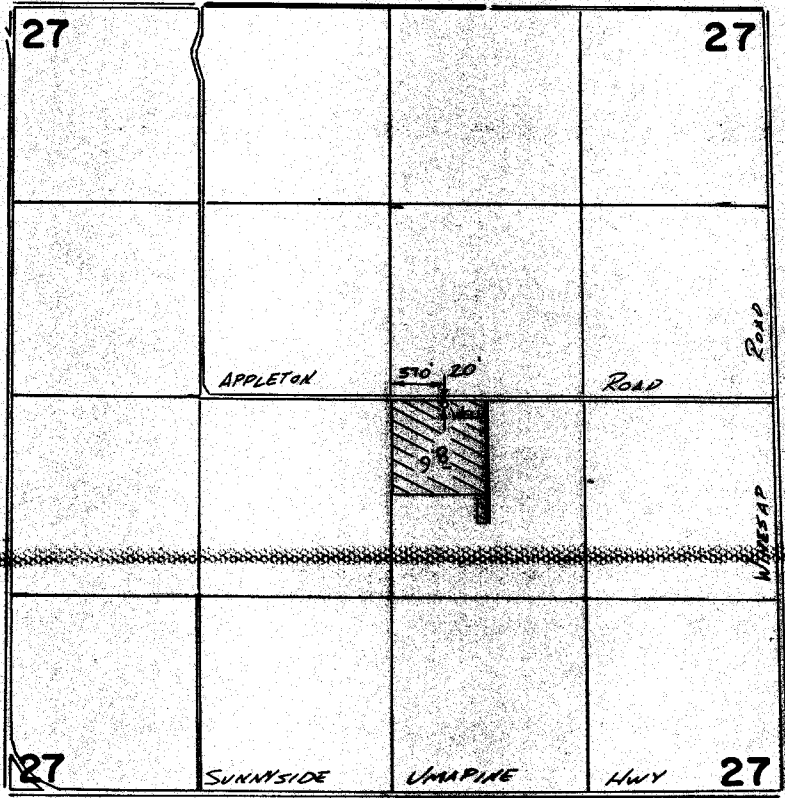

SCALE 1" = 1320'

**FINAL PROOF SURVEY**  
UNDER

Application No. **G:11417** Permit No. **G:10576**  
IN NAME OF

**JOHN A. LEFORE**

Surveyed **9-10** 19**87**, by **V.L. Church**