


T. 4N., R. 29E., W. M.

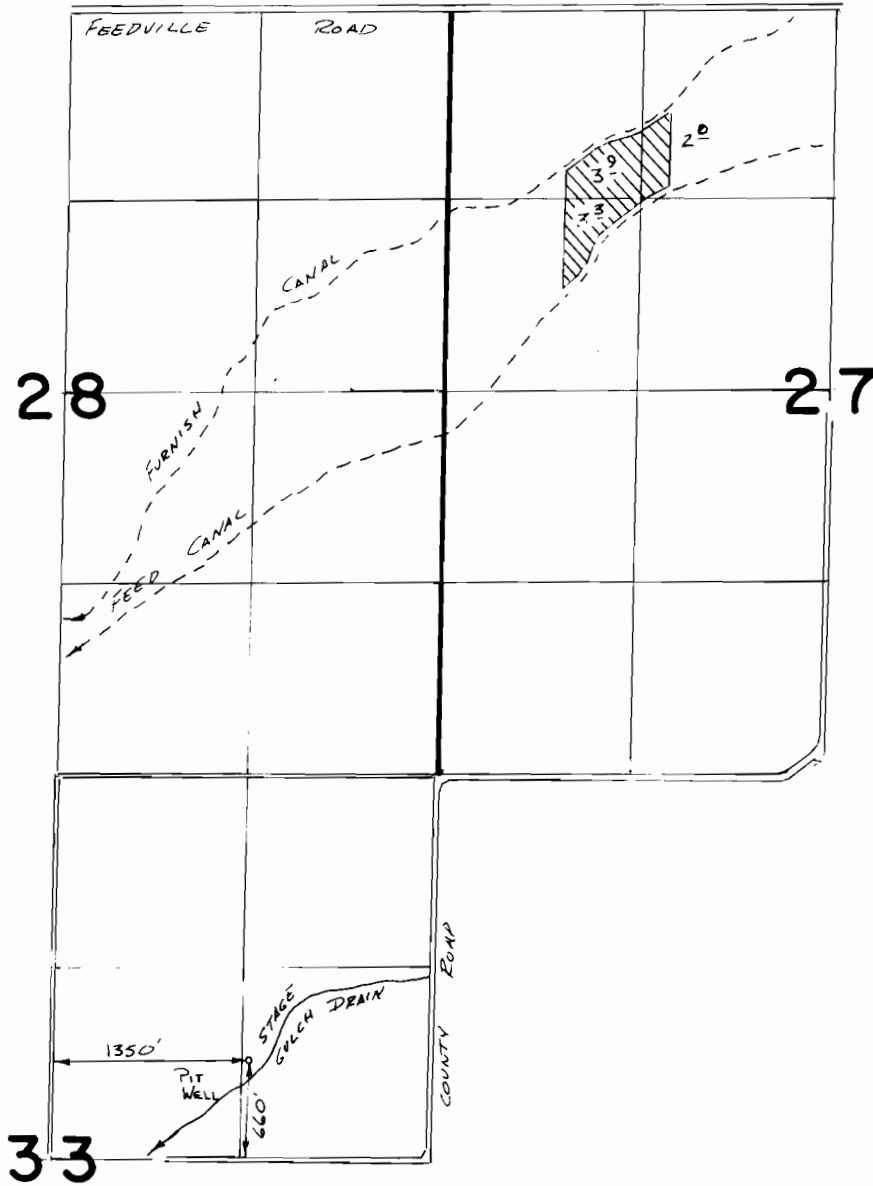

SCALE 1" = 1320'

FINAL PROOF SURVEY
UNDER

Application No. **G:11433** Permit No. **G:10587**
IN NAME OF

DON MILLS

Surveyed **2-4** 19**87**, by **V.L. Church**