


T. 2N., R. 33E., W.M.

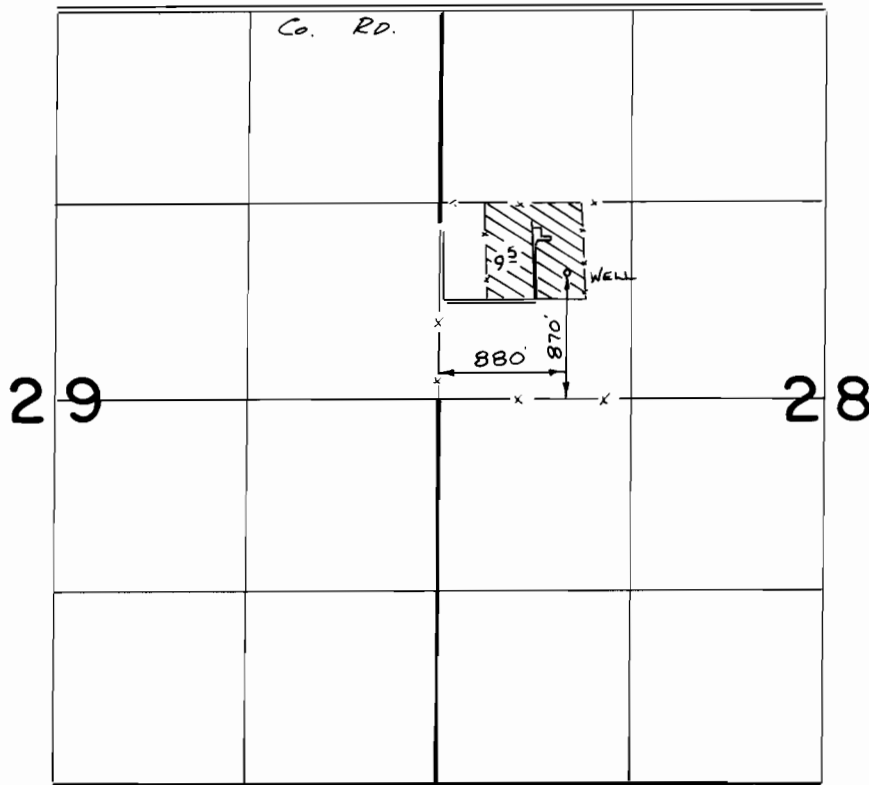

Scale 1" = 1320'

**FINAL PROOF SURVEY**  
UNDER

Application No. **G:11572** Permit No. **G:10682**.  
IN NAME OF

..... **HARRY H. BLISS** .....

Surveyed ..2-2..... 1987., by *V.L. Church*.....