


T. 2N., R. 14E., W.M.

SECTION 31 SW¹/₄ SW¹/₄

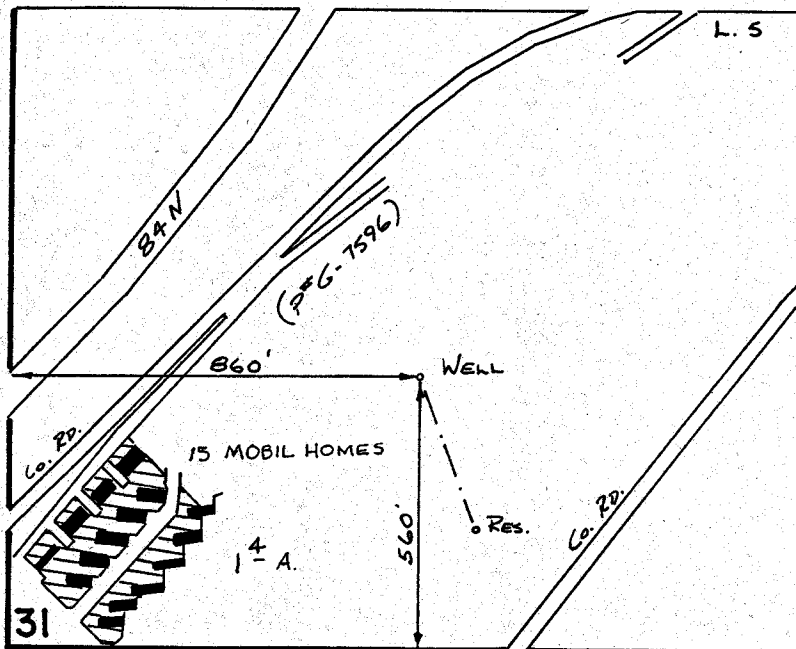

Scale 1" = 400'

FINAL PROOF SURVEY
UNDER

Application No. **G:11594** Permit No. **G:10699**
IN NAME OF

CECIL & DOROTHY BYERS

Surveyed 4-14 1989, by *V.L. Church*