


T. 12 S., R. 8 W., W.M.

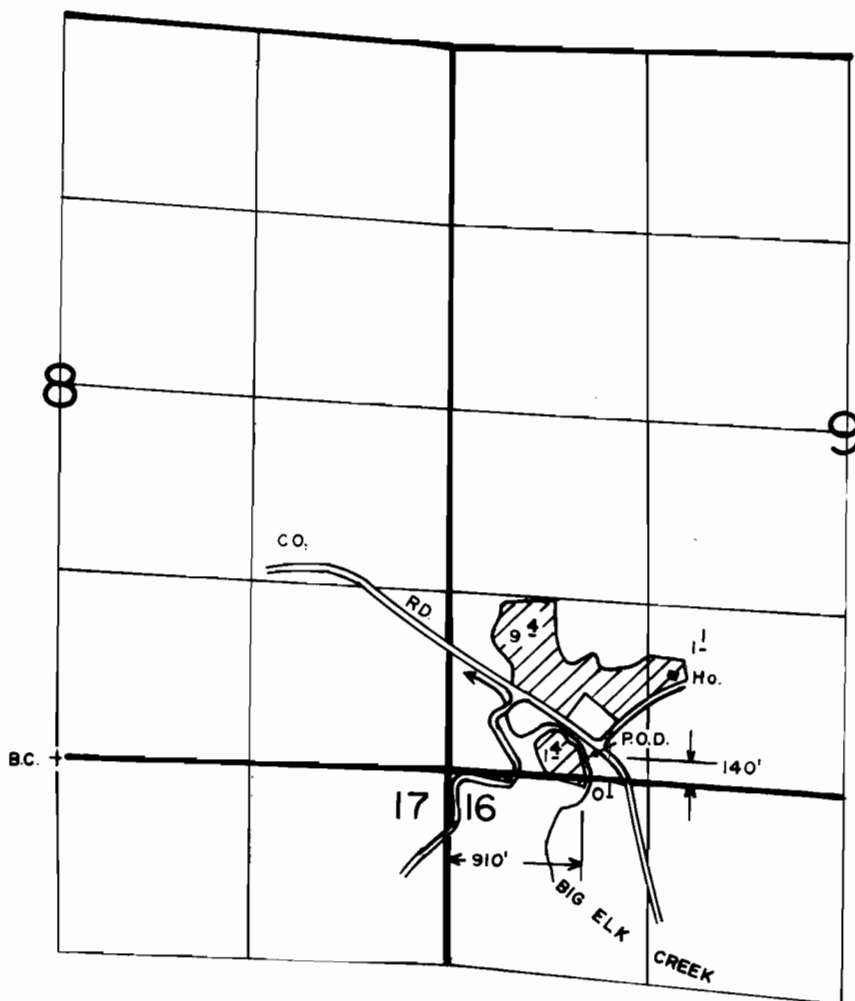

FINAL PROOF SURVEY UNDER

Application No. 56159 Permit No. 42302.....
IN NAME OF

ELLIN KNOWLES

Surveyed SEPT. 20 1983, by L. TOLL.....
NOV. 13 1989 T.M. WARREN

8-28-90 DSM
41041-372-62