


T10S. R4W. WM.

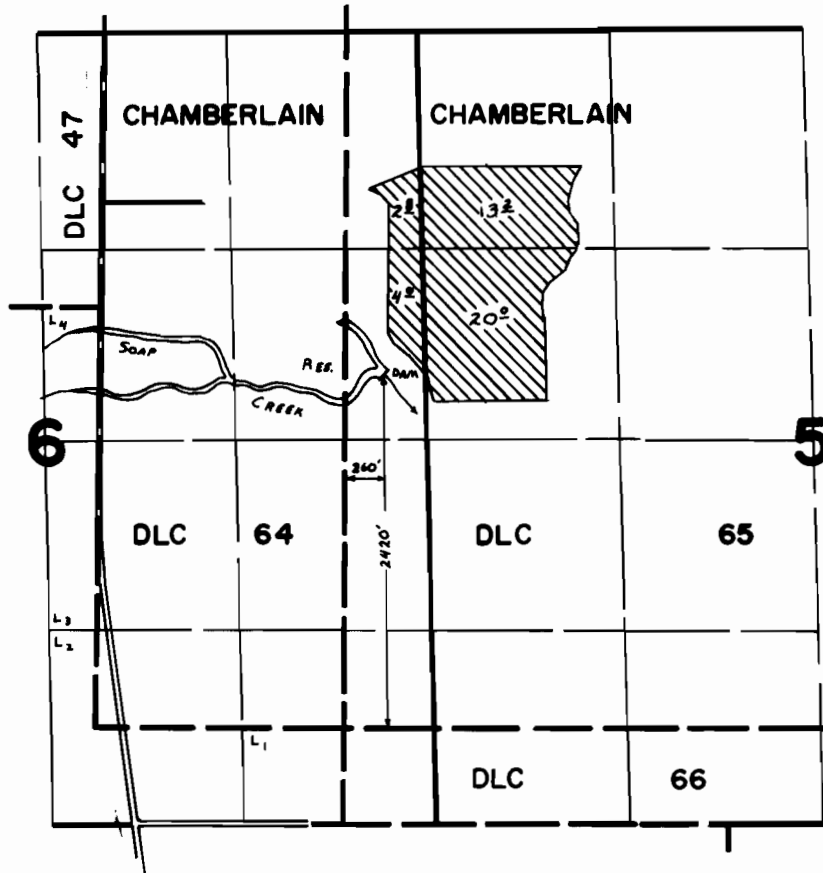

FINAL PROOF SURVEY UNDER

R-56212 R-6689

Application No. 56213... Permit No. 42245.....

IN NAME OF

GEORGE GORDEN

Surveyed July...19... 19.79., by C. L. HUGHES.....