


T. 40 S., R. 14 W., W.M.

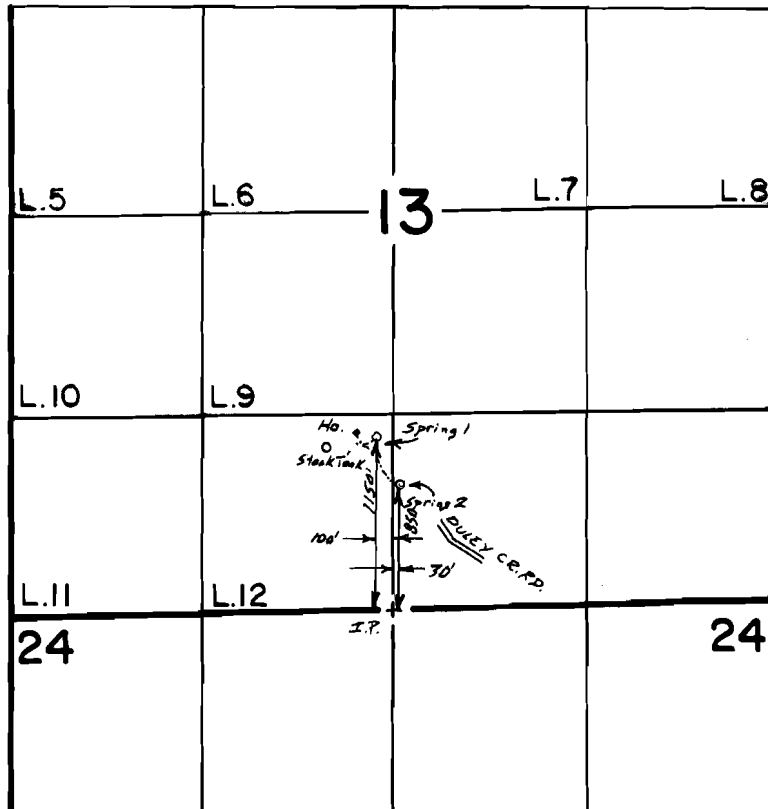

Scale 1" = 1320'

FINAL PROOF SURVEY
UNDER

Application No. 56403 Permit No. 42136.....
IN NAME OF

JIM F. & DONNA M. BLUNT.....

Surveyed Sept. 4, 1987, by J.M. SCHMORDE