


T. 40 S., R. 14 W., W. M.

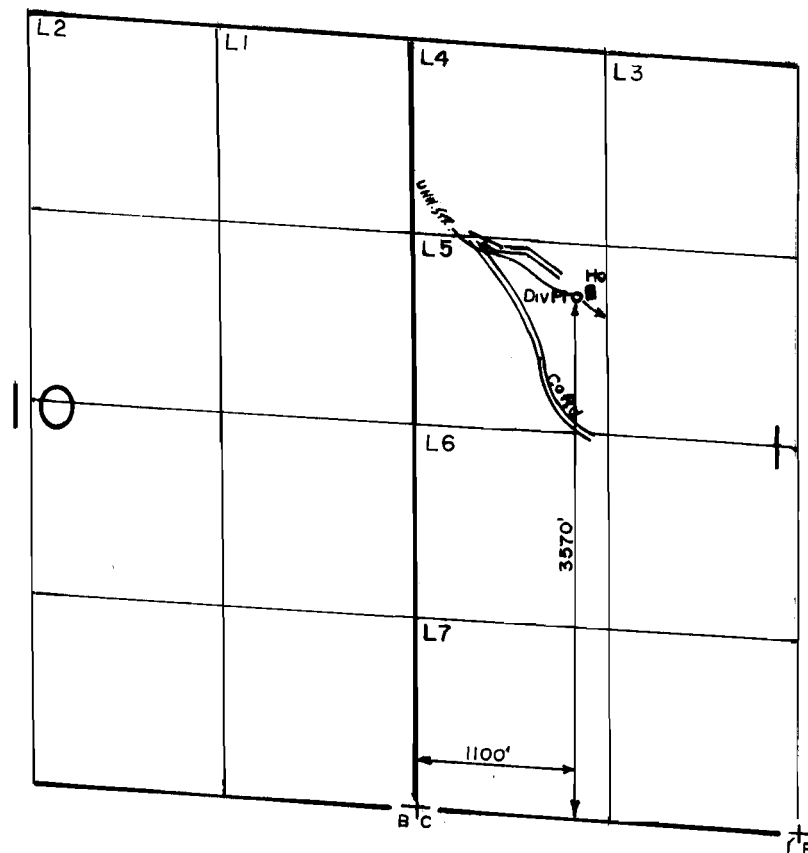

SCALE: 1"=1320'

FINAL PROOF SURVEY
UNDER

Application No. 56458.. Permit No. 42058.....
IN NAME OF

.....FREDERICK & BETTY McGUIRE.....

Surveyed JUNE. 6.. 1990., by B.S. JAMES.....