


T. 40S., R. 14W., W.M.

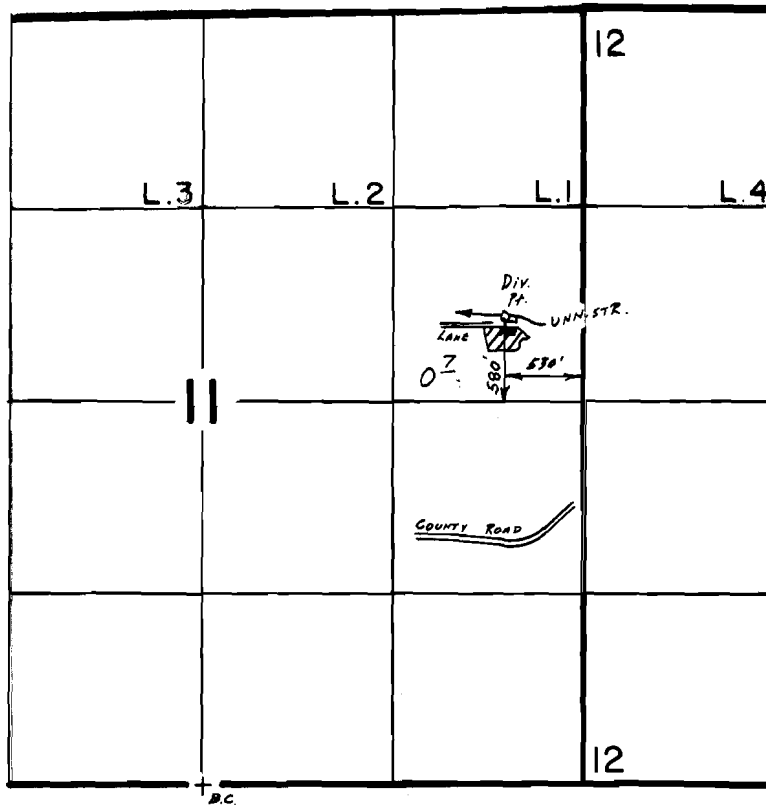

Scale 1" = 1320'

FINAL PROOF SURVEY
UNDER

Application No. 56591... Permit No. 42057.....
IN NAME OF

JAMES P. OLESON

Surveyed Sept. 2, 1987, by J.M. SCHMORDE