




T. 17 S., R. 44 E., W.M.

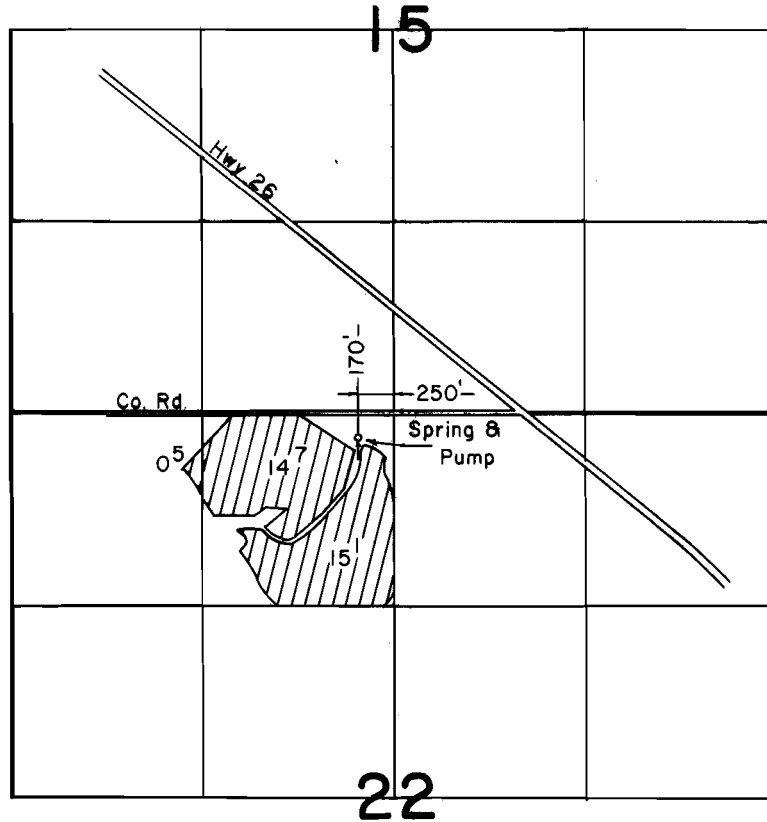

SCALE: 1" = 1320'

**FINAL PROOF SURVEY**  
UNDER

Application No. 56793.. Permit No. 42597.....  
IN NAME OF

.....**JOEL B. JOHNSON**.....

Surveyed **JUNE 16, 1986**, by **D. CLARK**.....