


T. 2 N. R. 11 & 12 E. W.M.

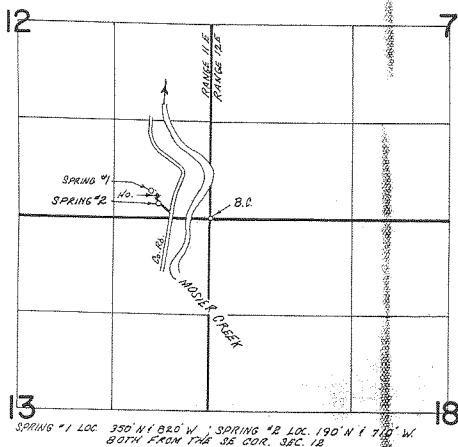

FINAL PROOF SURVEY
UNDER

Application No. 57219 Permit No. 43002
IN NAME OF

LEONARD & ELIZABETH HELSETH

Surveyed Oct. 25, 1983, by T.J. Paul