


T. 30S., R. 4W., W.M.

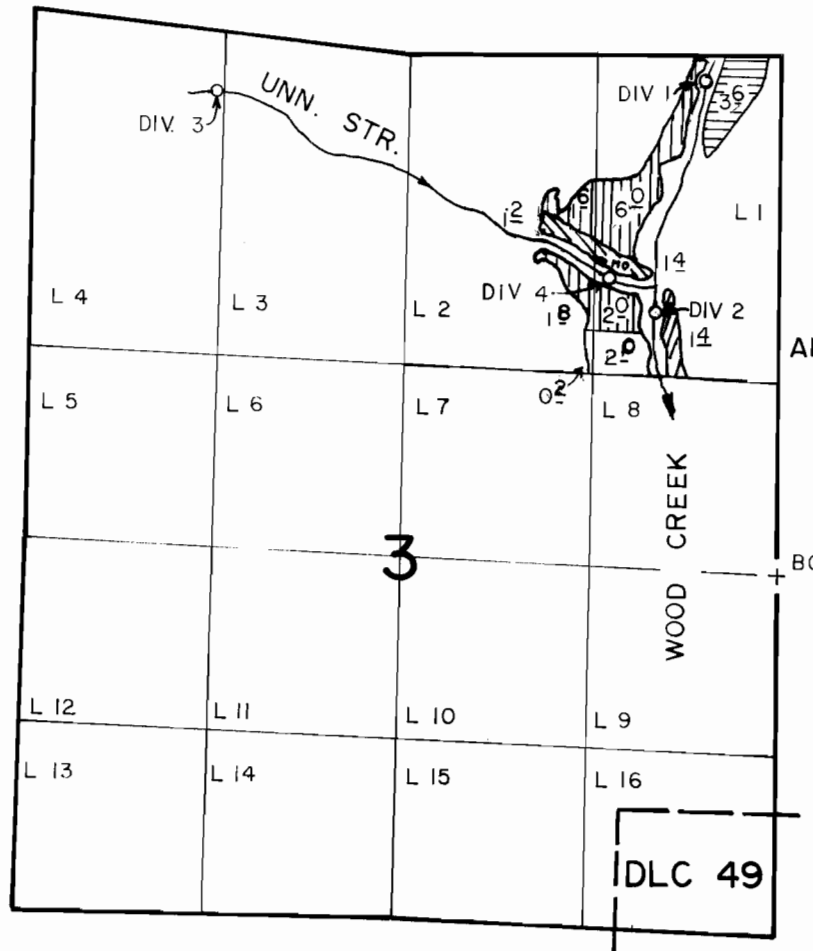

DIV 1 : 180' S., 500' W.
 DIV 2 : 1750' S., 820' W.
 DIV 3 : 210' S., 3900' W.
 DIV 4 : 1540' S., 1150' W.

ALL FROM NE CORNER
 of SEC 3.

AREAS IRRIGATED:

- DIV 1
- DIV 2
- DIV 3 Also Domestic
- DIV 4

SCALE: 4" = 1 mile

FINAL PROOF SURVEY UNDER

Application No. 57399... Permit No. 43552.....
 IN NAME OF

BILL & SUSAN MALLOY and MARY & GARNER TULLIS

Surveyed AUG...18.. 1983., by J.S. DONALDSON

Revised 1-4-90 DM
 30S 4W NE1/4

JEC