


T. 29S., R. 7 W., W. M.

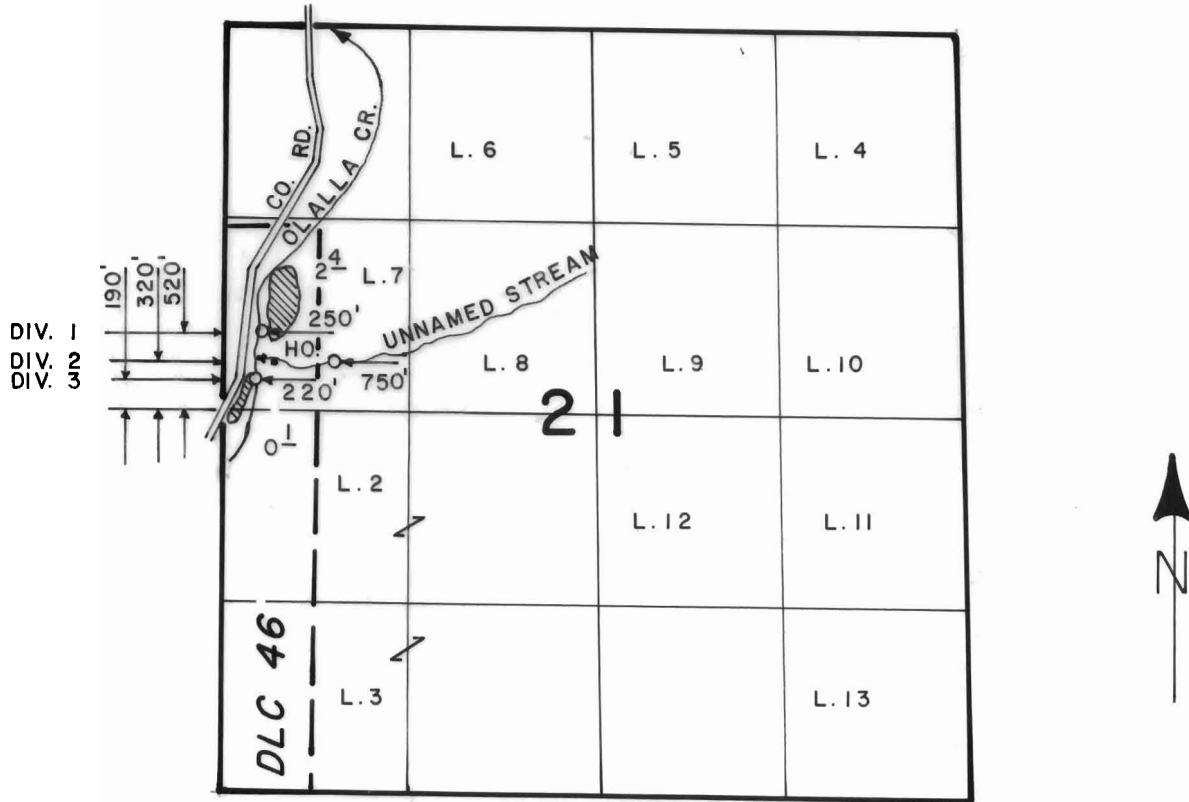

SCALE: 4" = 1 MILE

FINAL PROOF SURVEY UNDER

Application No. 57570 Permit No. 43364
IN NAME OF

IRA L. HARRIS

Surveyed JULY 1 1987, by J. M. SCHMORDE