


T. 40S., R. 14W., W.M.

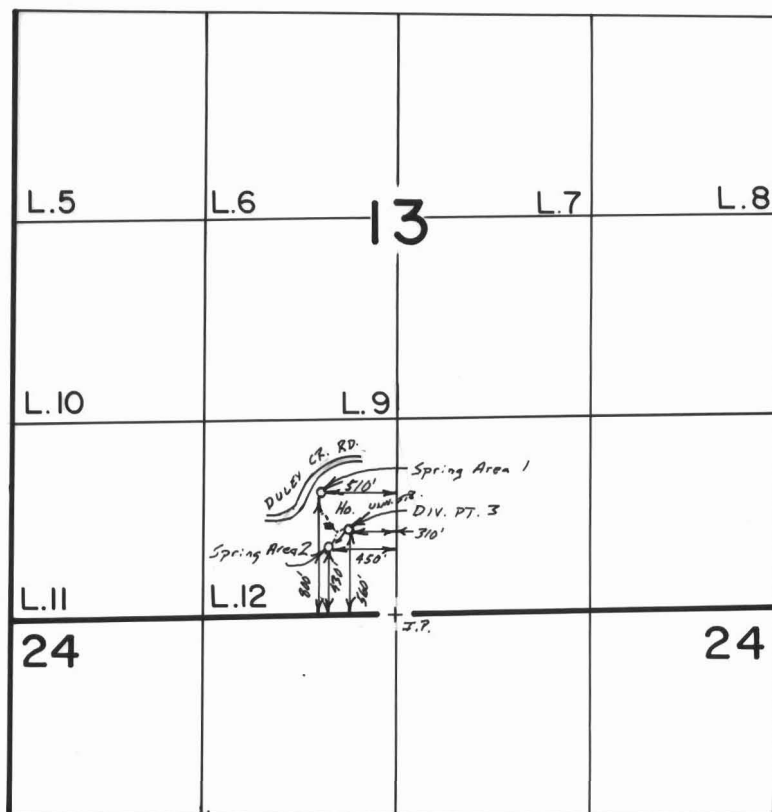

Scale 1" = 1320'

FINAL PROOF SURVEY UNDER

Application No. 57616 Permit No. 43665.....
IN NAME OF

EMMA JANE RADNER.....

Surveyed Sept. 29 1987, by L.M. JOACHIMS