


T.1S., R.39E., W.M.

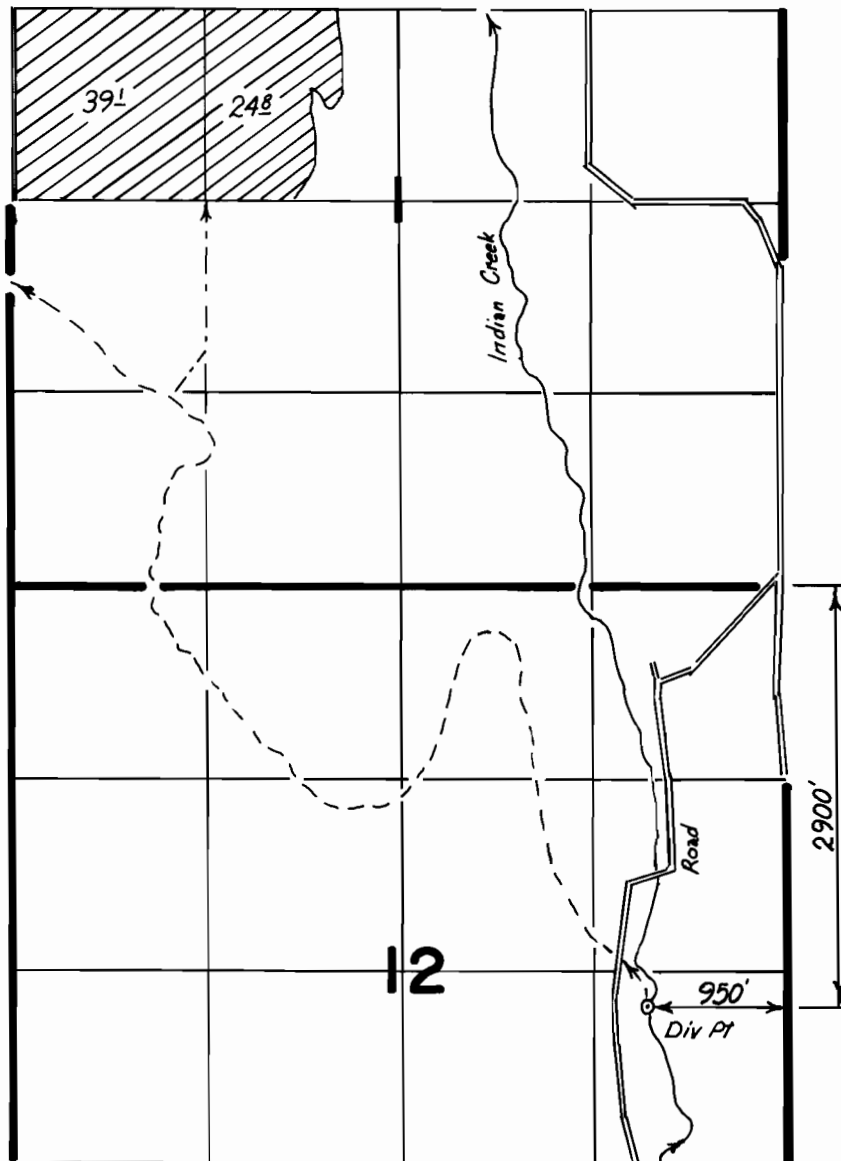


FINAL PROOF SURVEY
UNDER

Application No. 57779 Permit No. 43458
IN NAME OF

NECHA TARBELL

Surveyed 4-2 1987, by Vern Church

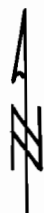

Scale : 1" = 1320'